REVISIONS:
REV: DATE: BY: RVW:

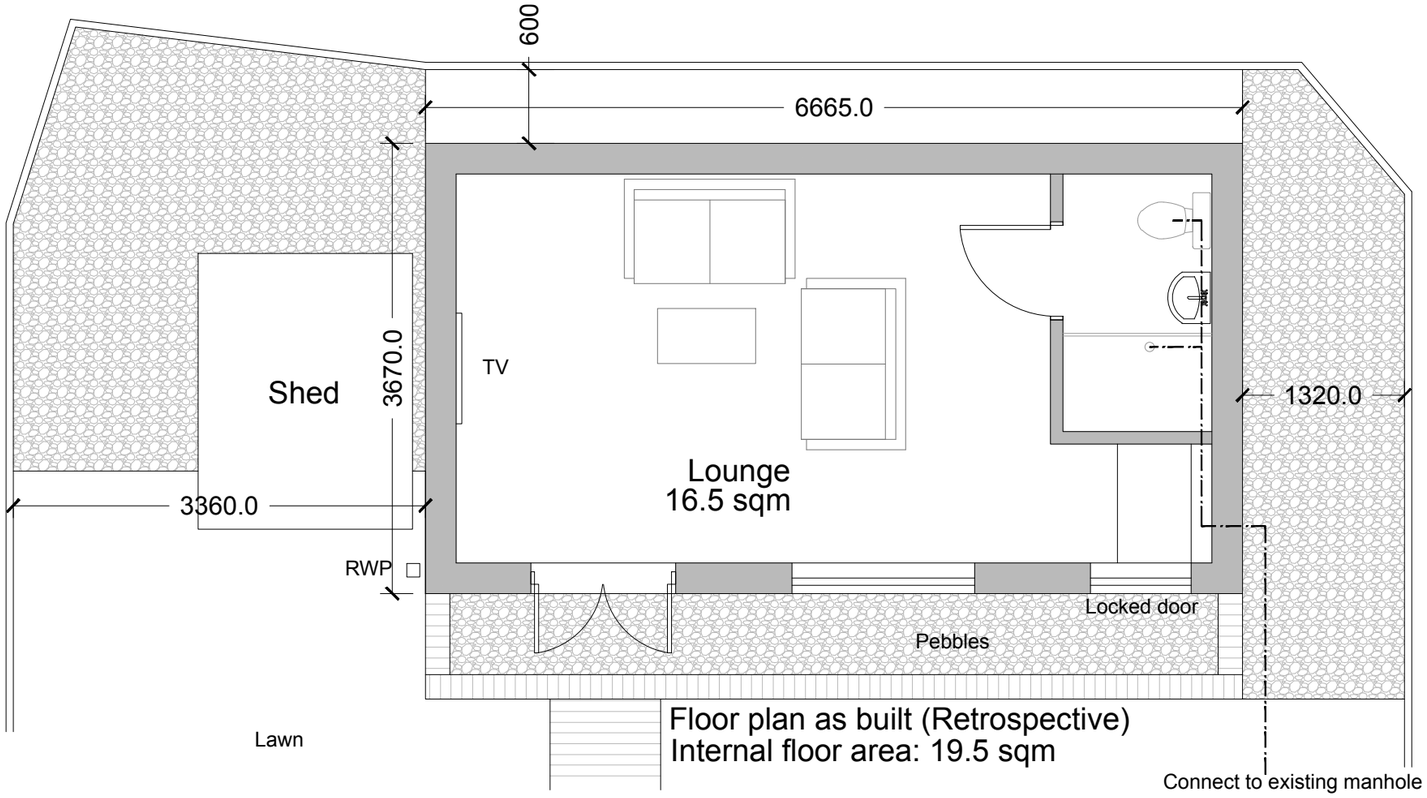

Floor plan as built (Retrospective)
Internal floor area: 19.5 sqm

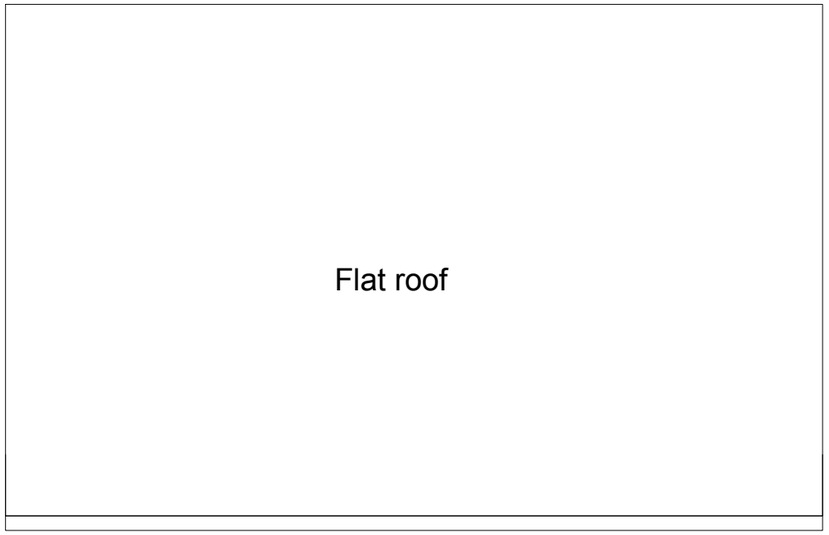

Roof plan as built (Retrospective)

Render in colour cream

uPVC double glazed window and doors in colour white

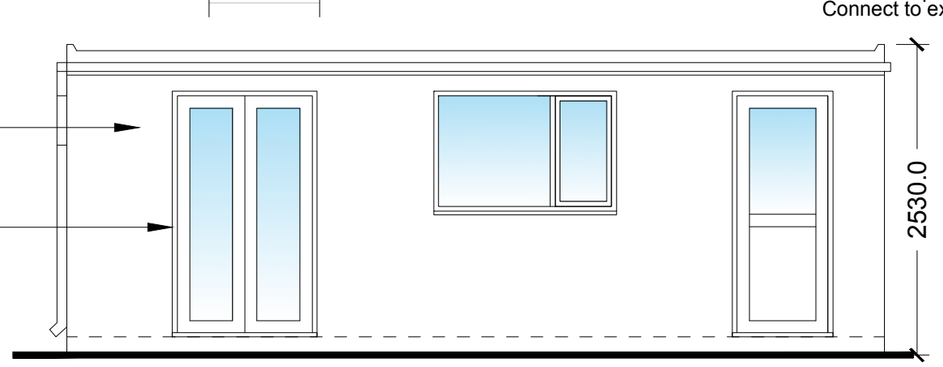

Front (North West) Elevation as built (Retrospective)

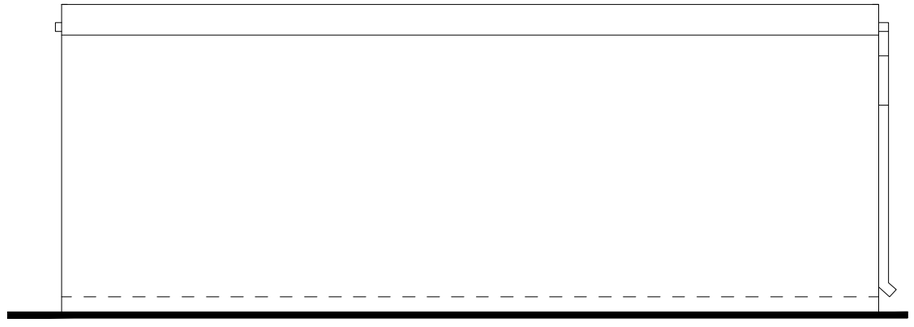

Rear (South East) Elevation as built (Retrospective)



Side (South West) Elevation as built (Retrospective)

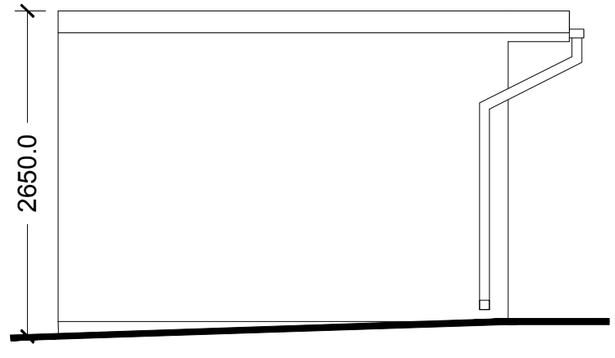

Side (North East) Elevation as built (Retrospective)

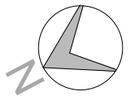

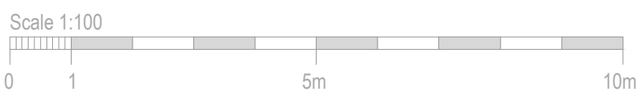

Wang Dao Architecture
3, 85 Pankhurst Avenue
Brighton, BN2 9AE
United Kingdom
m +44 (0)7491 809902
e info@wangdaoarch.com
w www.wangdaoarch.com

CLIENT
Angela and Terry

This drawing is for Planning Permission purpose only. All dimensions to be confirmed on site.

© This drawing is the sole copyright of Wang Dao Architecture Ltd.

Any discrepancies between this drawing & other information shall be reported to the Architect. MODIFICATIONS to be made solely on ORIGINAL MAGNETIC MEDIA.

PROJECT
Meadow Sweet
Old Salts Farm Road
Lancing
BN158JD

TITLE
Erection of garden cabin (Retrospective)
Plans and elevations as built

STATUS
Planning

DATE
December 2019

SCALE @ A3
1:100, 1:200

DRAWN BY
Edward

REVIEWED BY

DRAWING NUMBER
1925 PL1 02A

CTB file:
XREF'S:
LTscale: