1:100 @ A1

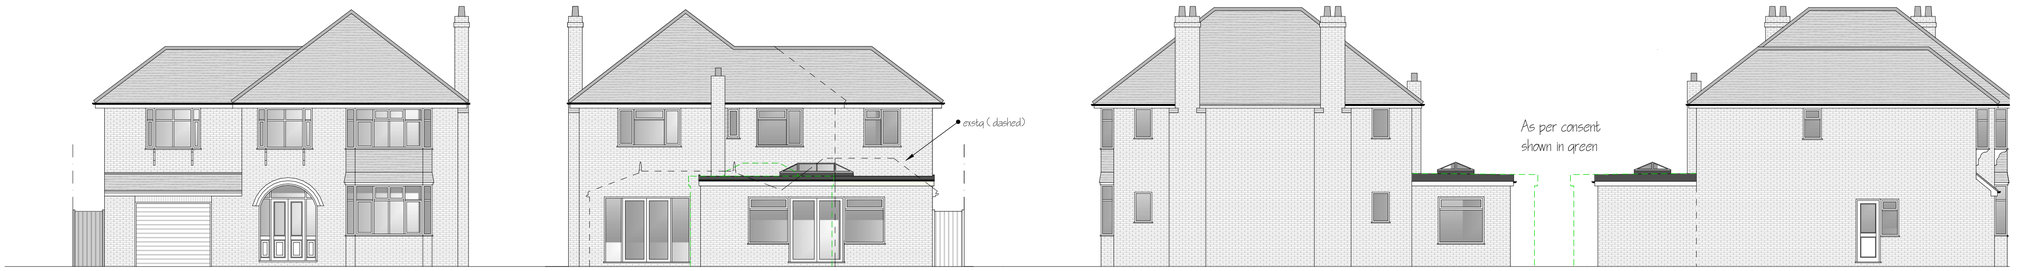

FRONT (WEST)

As per last consent
shown in green

REAR (EAST)

SIDE (SOUTH)

SIDE (NORTH)

PROPOSED AMENDED PLANS AND ELEVATIONS

1:50 @ A1

As per last application
shown in green
Exsta extension shown in blue
Proposed amendment shown in red - increase exsta extension by 2.76m - new flat roof

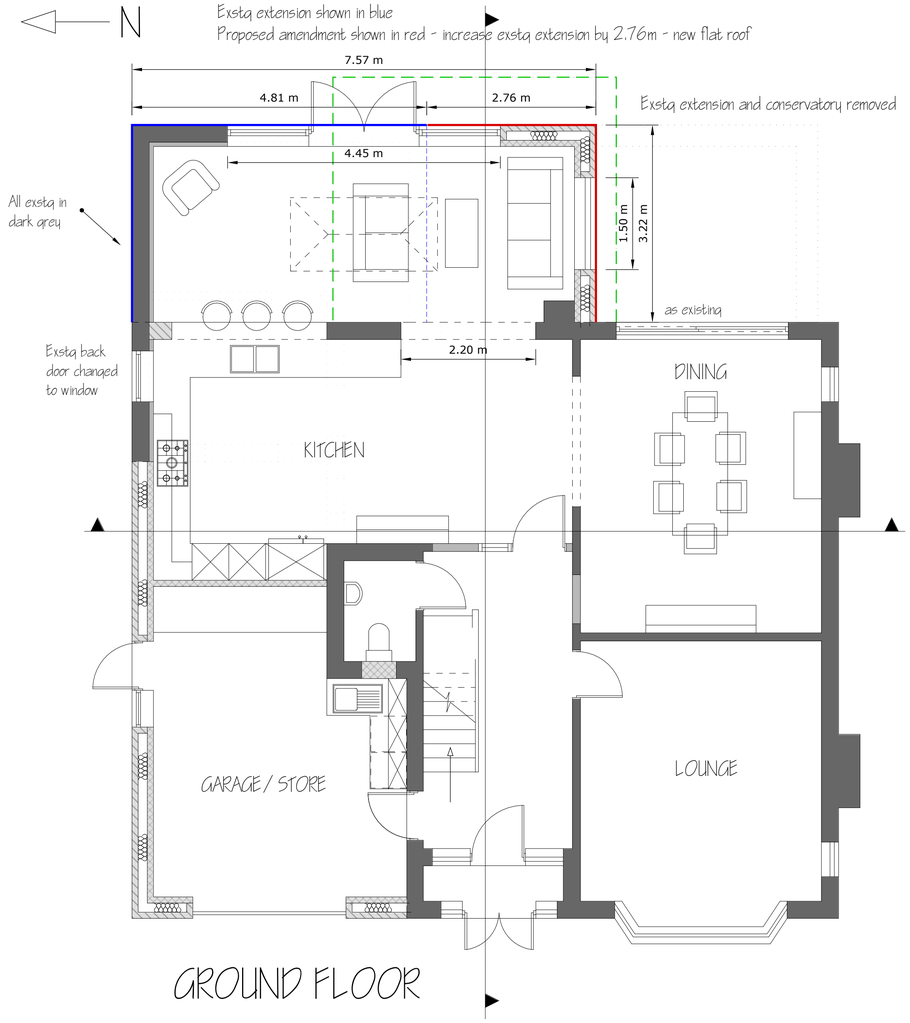

GROUND FLOOR

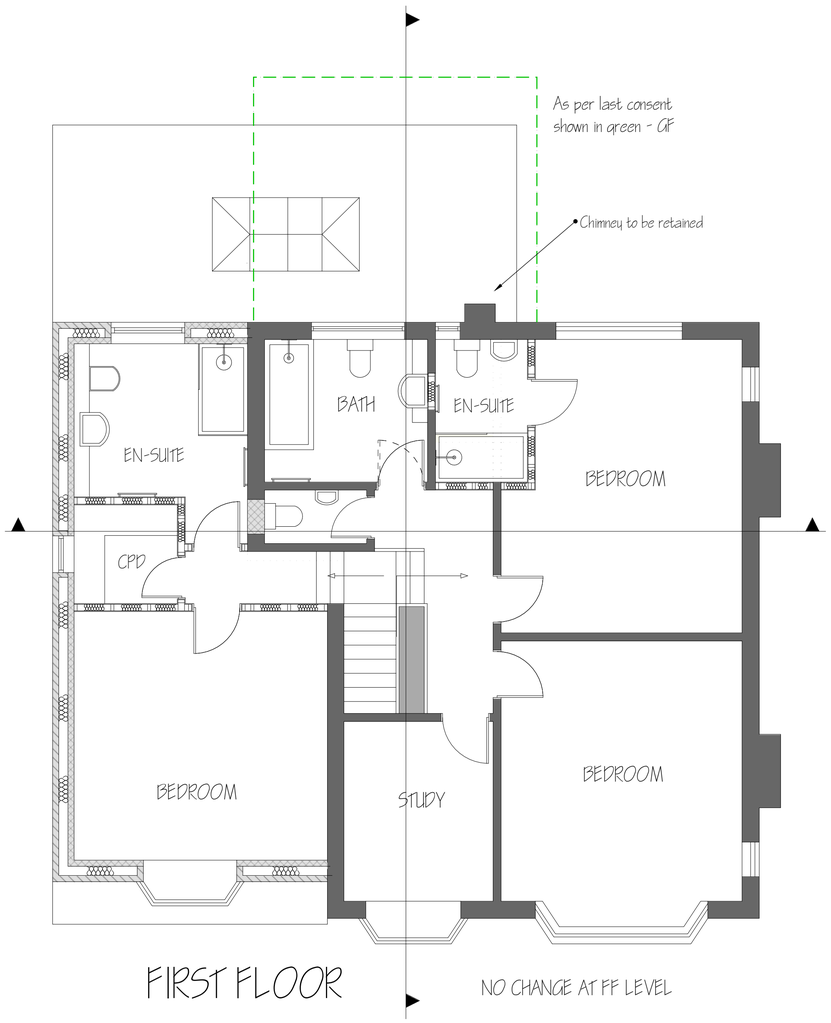

FIRST FLOOR

NO CHANGE AT FF LEVEL

ROOF PLANS 1:100 @ A1

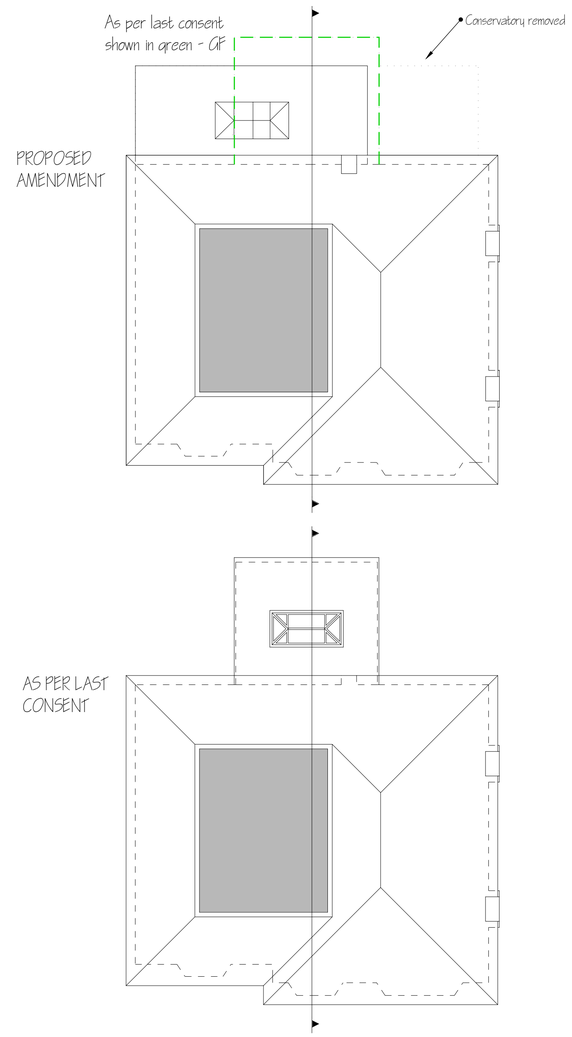

deadspace DESIGNS

PROPOSED EXTENSION WORKS at 52 SEA LANE, GORING-BY-SEA, WORTHING, WEST SUSSEX, BN12 4PY

DRAWING: AMENDED PLANS AND ELEVATIONS FOR NMA CONSIDERATION

SCALE: 1:100 & 1:50 @ A1

DATE: 09/ 01/ 2024

DRWG No: DS/ HARTIN NMA/ 02 rev2

1:50 @ A1 paper size 0 1 2 3m

1:100 @ A1 paper size 0 1 2 3 4 5m