

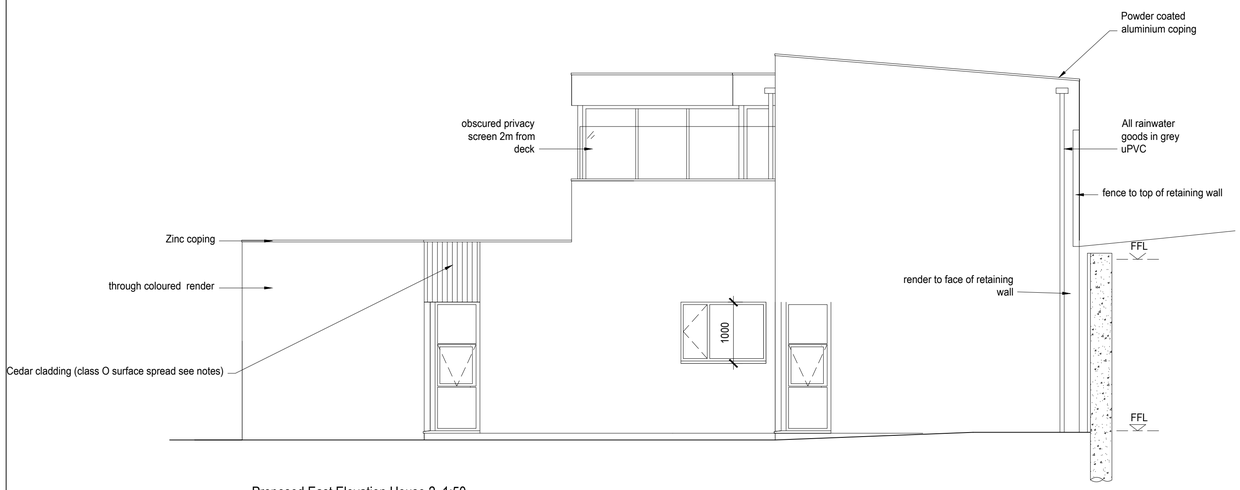



Proposed East Elevation House 2 1:50

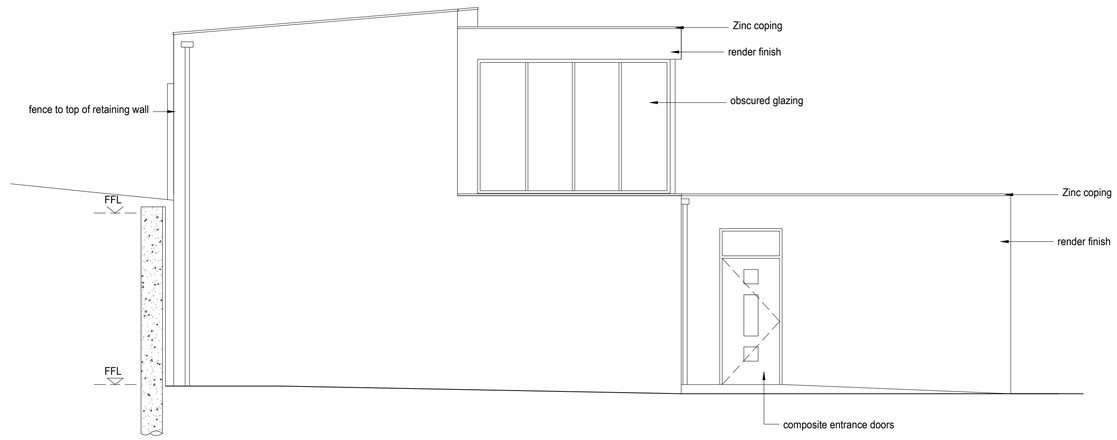


Proposed West Elevation House 2 1:50

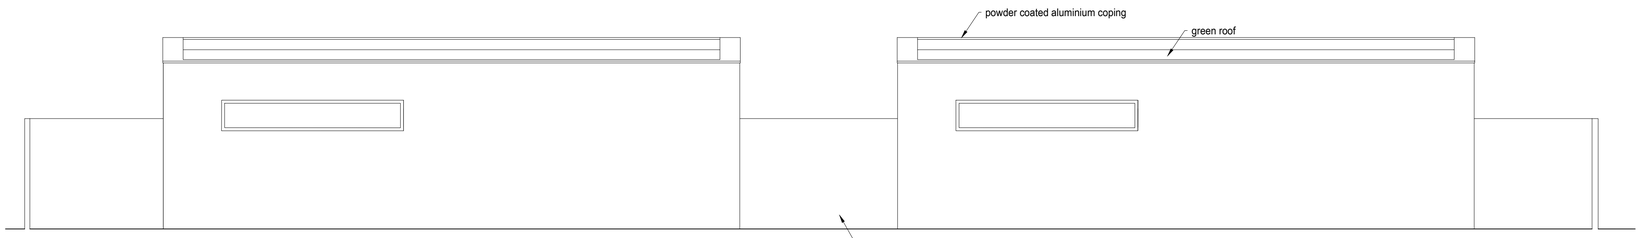

Proposed North elevation 1:50

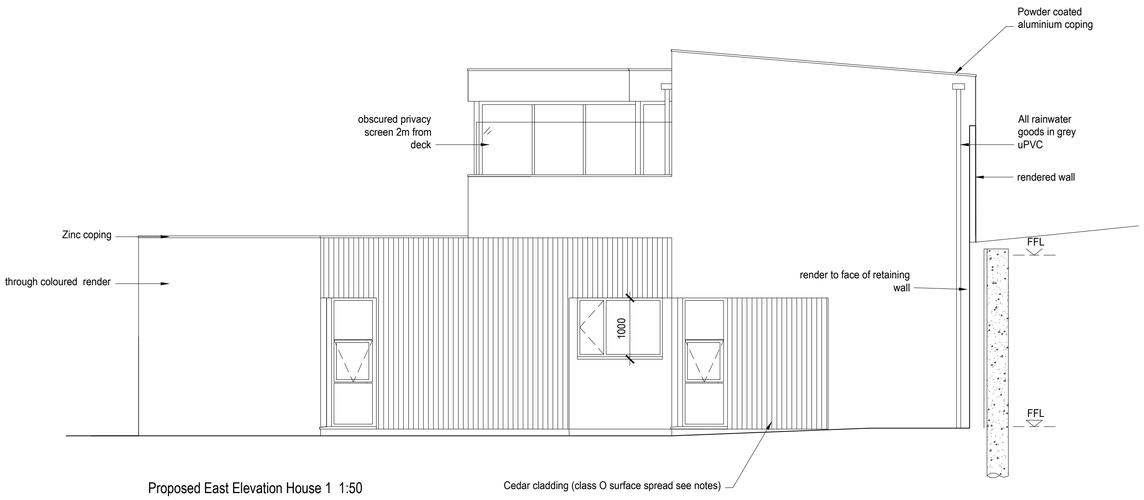

Proposed East Elevation House 1 1:50

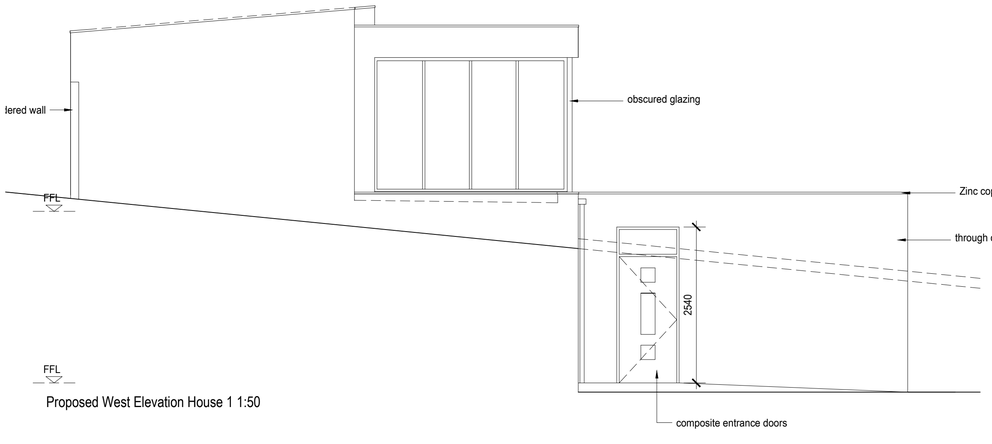

Proposed West Elevation House 1 1:50

Rev E 07.08.20 AS BUILT amendments

bpm Architectural Services Limited

client: 111a Arundel Road Development LLP

project: Land South of 14 Ring road
Norbury Drive
Lancing
West Sussex

project ref: 1515 Drawing No. BR03E

drawing title: Proposed elevations and sections

drawn by: J Boys

date: Sep 19 scale: 1:50@ A1

www.bpmnet.co.uk
info@bpmnet.co.uk

Do not scale off drawing, check all dimensions on site before all work is commenced

All goods materials workmanship to conform with current building regs BSS and COP's