

Ground Floor

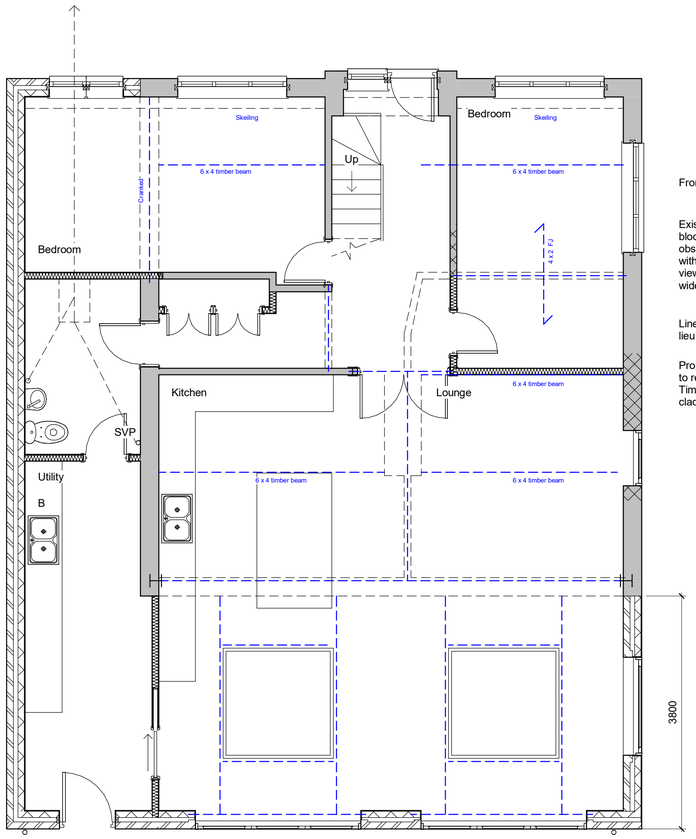

First Floor

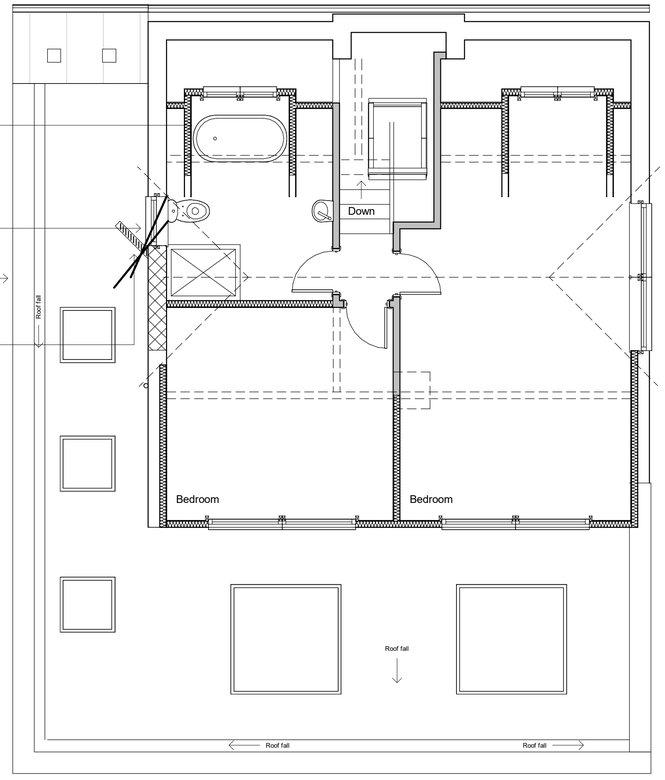

Materials

Roof covering - Grey zinc colour standing seam roof covering


https://uk.prefa.com/product-catalogue/roof-systems/roof-system-prefalzr/



Cladding - Larch timber cladding

https://www.russwood.co.uk/cladding/products/scotlarch/



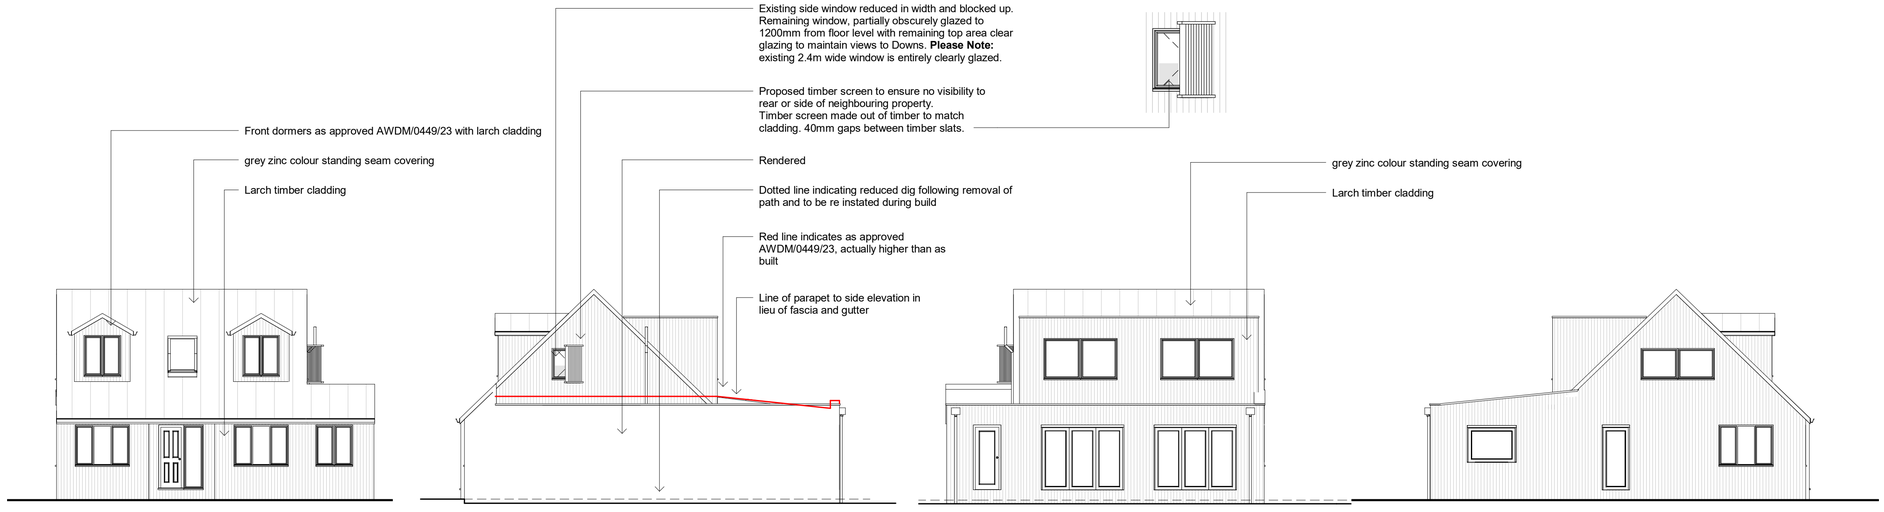

Front Elevation - East

Side Elevation - North

Rear Elevation - West

Side Elevation - South

Revisions

0.5 0 0.5 1 1.5 2 2.5
SCALE 50 m
1:

1 0 1 2 3 4 5
SCALE 100 m
1:

Materials

Drawing Number	2023/22	Sheet	1 of 1
Size	A1	Scale	1:50, 1:100

Project

As built
October 2023

Job Title

1 Weald Dyke
Shoreham-by-Sea
West Sussex
BN43 5LP

Do Not scale from this drawing except for planning as photocopies will be subject to distortion
Drawings to be read in conjunction with all other Designers and structural engineers contract drawings and specifications:
Any discrepancies must be brought to the attention of the Desiqner immediatialy.
The contractor must verify all dimensions by site measurement before ordering materials or manufacturing components
Substitute materials and products to those named will be acceptable if proven to be of equal or higher performance and not in conflict with other elements

M.J.Humphrey Ltd

RICS cabe chartered association of building engineers

Mel Humphrey MRICS, MBEng
9 Aldsworth Avenue
Goring By Sea
West Sussex
BN12 4XQ

Mel@mjhumphrey.co.uk
07701055182

Adam Humphrey
230 Dominion Road
Worthing
West Sussex
BN14 8JL

Adam@mjhumphrey.co.uk
07812419142