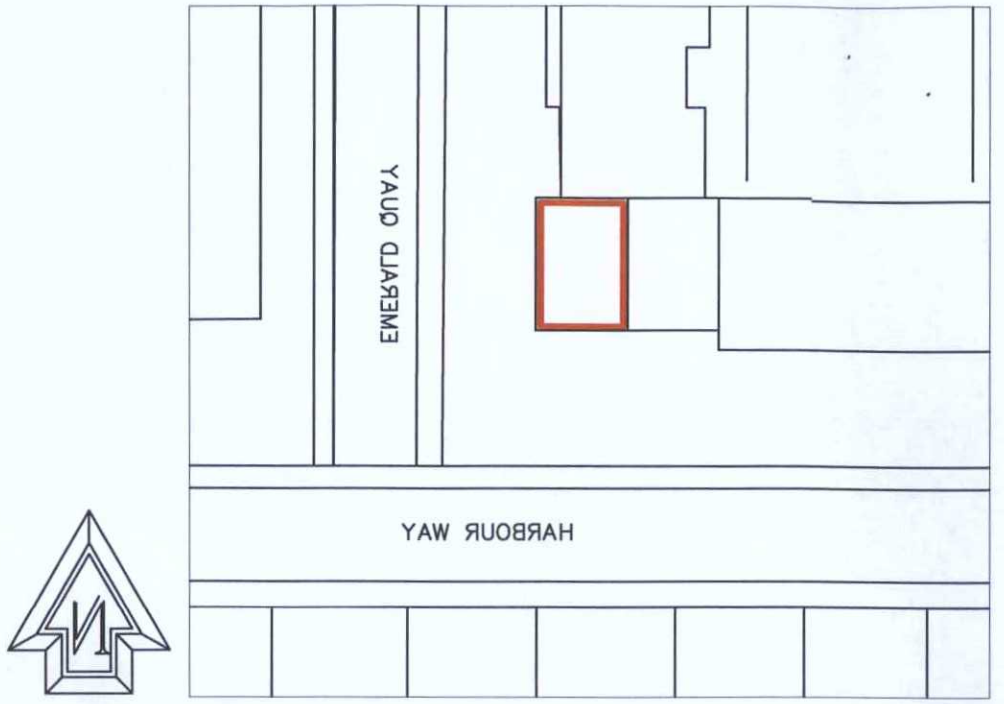

BLOCK PLAN 1:500

10m 20m 30m 40m

1:500 Scale Bar

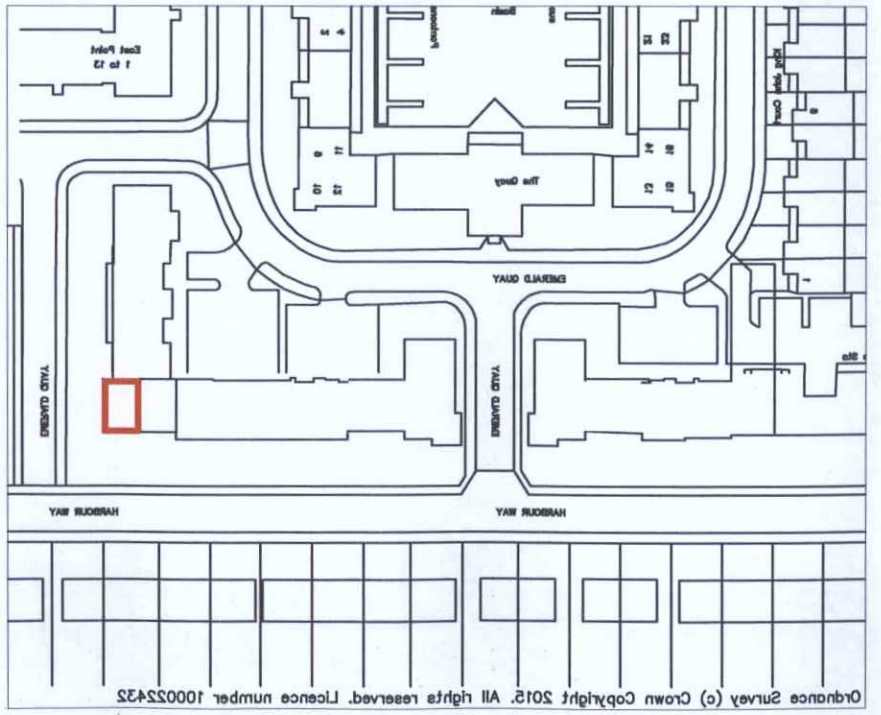

Location PLAN 1:1250

10m 20m 30m 40m 50m

1:1250 Scale Bar

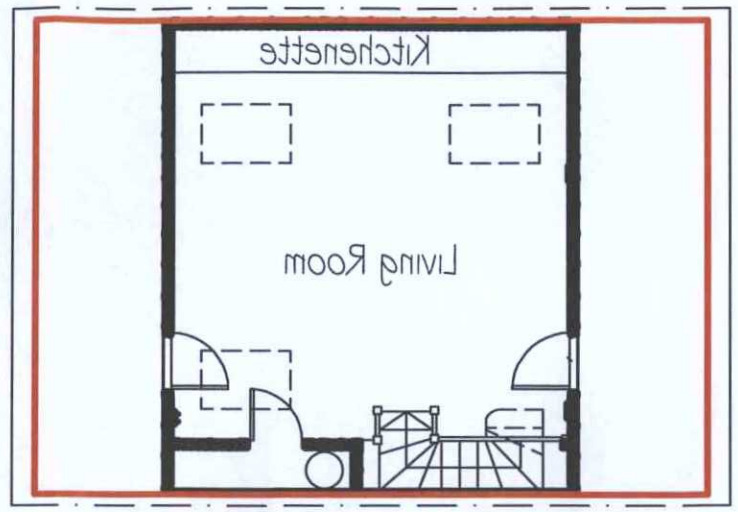

Third Floor Plan 1:100

1m 2m 3m 4m 5m 6m 7m 8m 9m 10m

1:100 Scale Bar

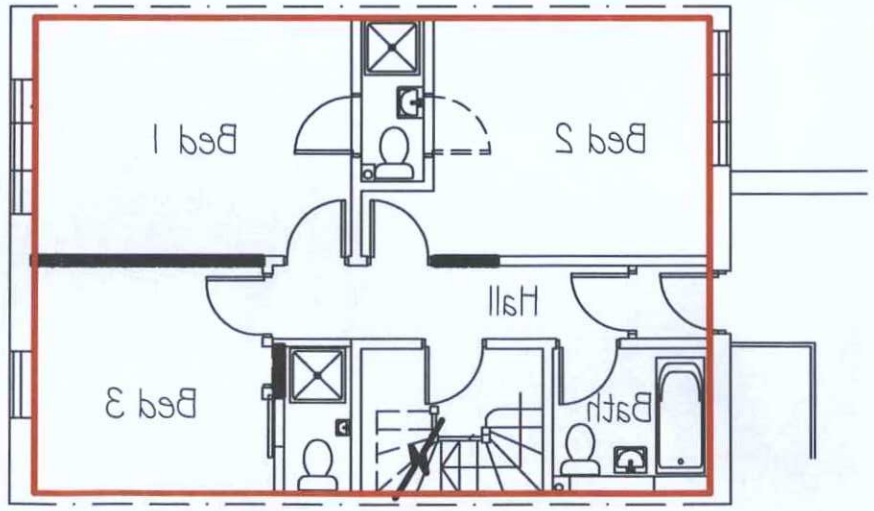

Second Floor Plan 1:100

ADUR & WORTHING
PLANNING SERVICES

PLAN | AWDM/0703/15

DATE VALID | - 8 JUN 2015

Copyright of:

BJW

Architectural & Planning Services
15 West Street
Shoreham By Sea
West Sussex
BN43 5WF

01273 441009
07856899101

e-mail: benw@bjwarchitectural.co.uk
website: bjwarchitectural.co.uk

Project:

FLAT 26 Kings Charles Place (second & third Floor)
EMERALD QUAY
SHOREHAM BY SEA
WEST SUSSEX
BN43 5UH

Title:

Floor Plans As proposed & as built

Note: All dimensions to be checked on site.

Client:

Scale: 1:500, 1:1250 & 1:100 @ A3 paper size

Date: 8.4.2015 Drawn: BJW

Drg. No. 05 | Rev'n