AMENDMENT

ADUR & WORTHING
PLANNING SERVICES

~~PLAN~~	~~AWDM~~/0434/16
~~DATE~~ VALID	Rec: 15/6/16

HIP TO ~~GABLES~~ & REAR DORMER BUILT ~~UNDER~~ P/D RIGHTS

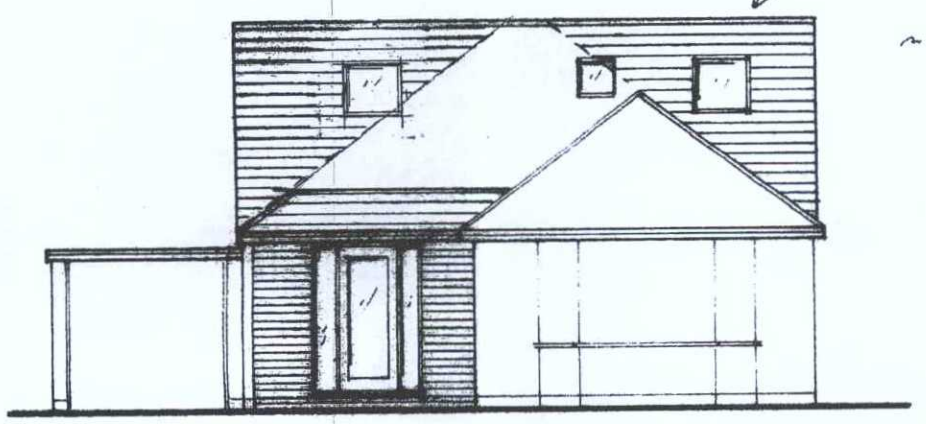

FRONT ELEVATION 1:100

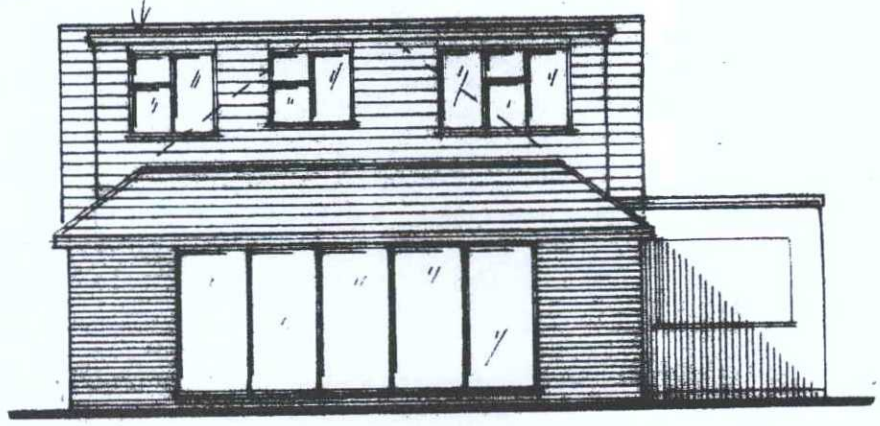

REAR ELEVATION 1:100

DORMER & GABLE BUILT UNDER P/D RIGHTS & NOT PART OF PLANNING APPLICATION

TILING TO MATCH EXIST.NG

BRICKWORK TO MATCH EXISTING

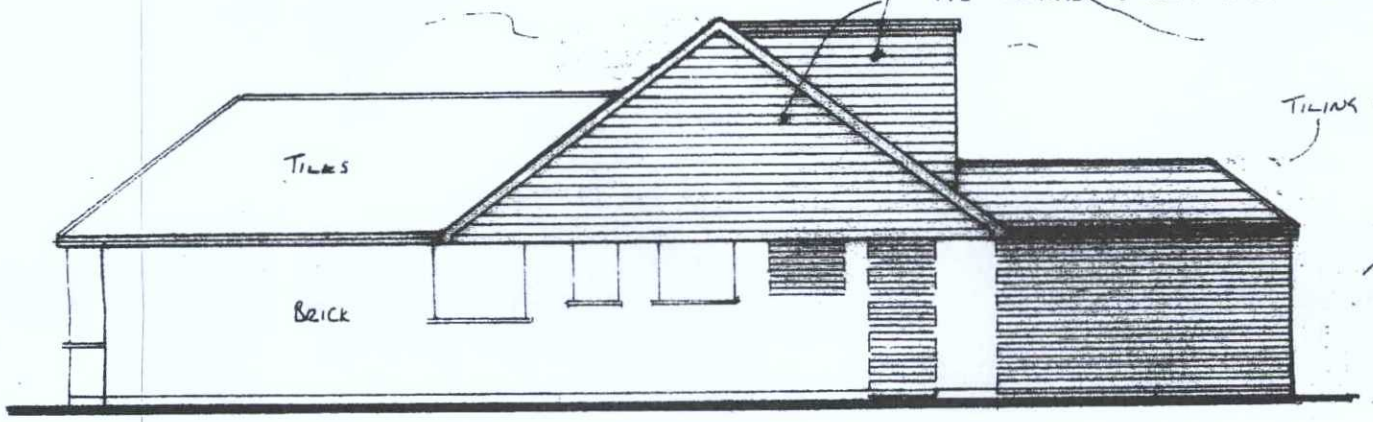

SIDE ELEVATION 1:100

~~DORMER & GABLE BUILT UNDER P/D~~ RIGHTS

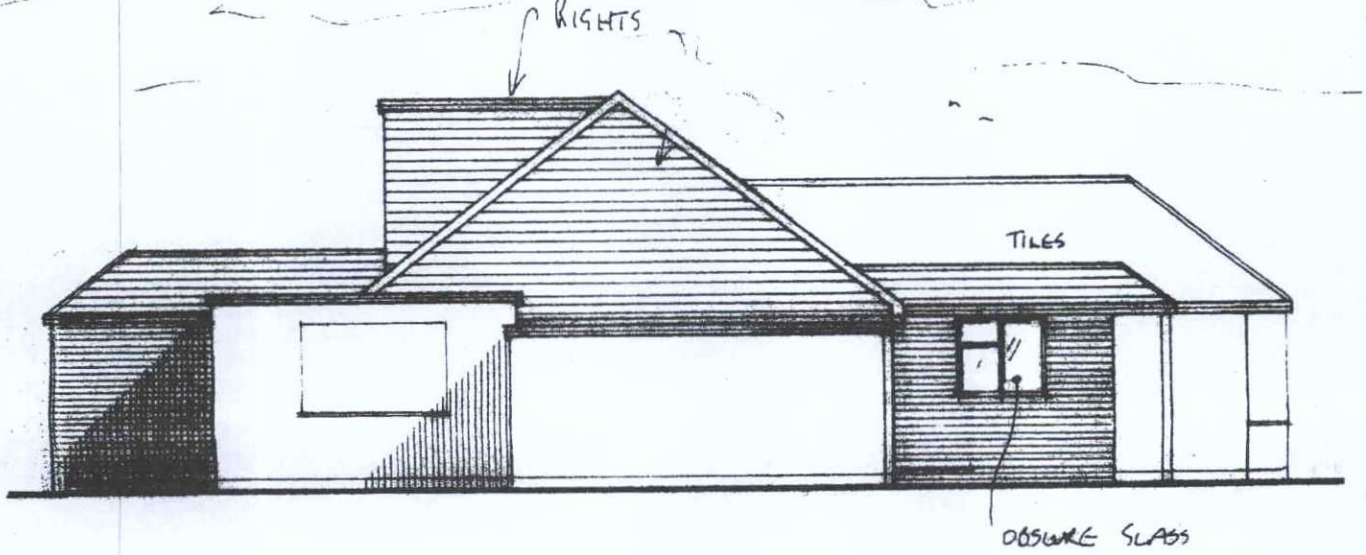

SIDE ELEVATION 1:100

1:100 0 1 2 3 4 5 6 7 8 9 10 11 12 13 14 15

ADUR & WORTHING
PLANNING SERVICES

PLAN	AWDM/0434/16
DATE VALID	- 4 APR 2016

BSB PARTY WALL AND ARCHITECTURAL SERVICES

Steve Barrett
C.Build E, CABE, MFPWS, Assoc RICS
Tel: 07519 384248
e.mail: bsbpartywalls@yahoo.co.uk
web: bsbpartywallservices.co.uk

ADDRESS: 47 BARFIELD PK, LANCING
CLIENT: MR & MRS WHITTINGTON
DATE: SEPT 15
DRAWING No. BSB/15/353/1/~~A~~ B
PROJECT: ROOMS IN ROOF & REAR EXTENSION

The Party Wall etc. Act 1996
The property owner is reminded of their duty to serve notices on all adjoining owners.
Structure
Read in conjunction with structural engineers calculations.

NOTES:
EXTENSION REQ'S PLANNING
ROOMS IN ROOF ARE P/D

NORTH

A3