NOTES.

T.P. OFFICE COPY

No dimensions are to be scaled from this drawing.
All dimensions are to be checked on site.

BOROUGH OF WORTHING
DEPOSITED 10/4/08
WB/ 08 0392/Full



North elevation - (existing.)



North elevation - as built.

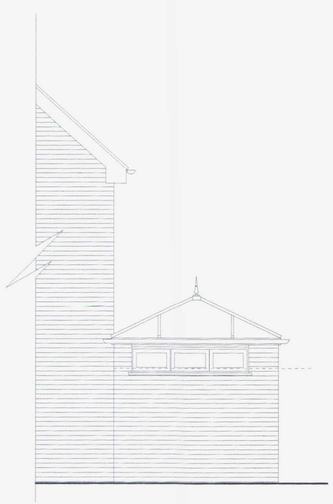

East elevation - as built.

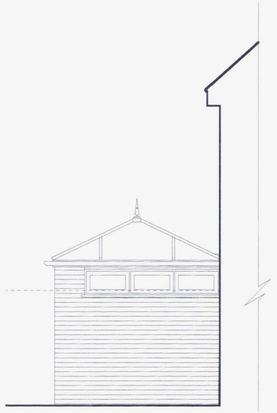

West elevation - as built.

WORTHING BOROUGH COUNCIL
- 5 JUN 2008
CONSENT GRANTED
SUBJECT TO CONDITIONS

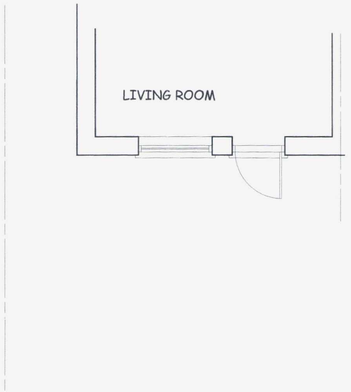

Part ground flor plan - (existing.)

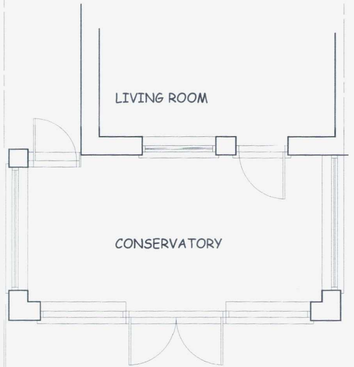

Part ground floor plan - as built.

8 LEEDS CLOSE, DURRINGTON.

For

PROPOSED REAR CONSERVATORY.

THE ALEXANDER PARTNERSHIP. Tel/fax: 01273 430304.
9 Middleton Avenue, Hove, East Sussex. BN3 4PH.

PLANS AND ELEVATIONS.

Scale: 1:50. Date: April 2008. Drg. No: 01/0804432.