SAFETY, HEALTH AND ENVIRONMENTAL INFORMATION

NOTES BELOW ARE ADDITIONAL TO HAZARDS/RISKS NORMALLY ASSOCIATED WITH THIS TYPE OF WORK.
FOR DETAILS REFER TO DESIGNERS RISK ASSESSMENT REF 10785-RAM-XX-XX-SH-CM-0002.

GENERAL SITE HAZARDS :-

1. BURIED SERVICES - CONTRACTOR TO HAVE A PROTOCOL IN PLACE FOR MANAGEMENT OF AN INCIDENT SHOULD A BURIED SERVICE BE STRUCK.
2. UXO AND OTHER OBSTRUCTIONS - RISK ASSESSMENT OF UXO FOR THE WORKS TO BE AS LOW AS REASONABLY PRACTICABLE AND INCLUDED IN THE CONTRACTOR'S RAMS. OBSTRUCTIONS FOUND TO BE RECORDED IN THE H&S FILE. DESK BASED STUDY CARRIED OUT IN 2009 BY OTHERS DESCRIBES THE SITE AS HAVING A MEDIUM UXO RISK. ADDITIONAL UXO STUDY TO BE COMPLETED PRIOR TO ANY CONSTRUCTION WORK.
3. OBSTRUCTION - TIMBER STRUCTURES NOT TO BE DISTURBED AS FAR AS REASONABLY PRACTICABLE.
4. TIMBER MATERIAL - POTENTIAL GREENHEART WOOD (TOXIC)

CONSTRUCTION (INCLUDING DEMOLITION AND REMOVAL OF EXISTING STRUCTURAL COMPONENTS) :-

5. WORKING NEAR WATER - SITE PERSONNEL TO WEAR LIFE JACKETS ON SITE - TO BE RISK ASSESSED BY THE CONTRACTOR.
6. WORKING AT HEIGHT - SITE PERSONNEL TO BE VIGILANT IF STEPPING ON OR OFF OF THE TOP OF THE REVETMENT.
7. WORKING WITH TIDES - CONTRACTOR TO PROGRAMME WORKS TO CONSIDER LOW TIDE WINDOWS.
8. ROCK INSTABILITY - CONTRACTOR TO ENSURE ROCKS ARE INSTALLED WITH THREE-POINT CONTACT. IF ACCESS TO ROCKS IS REQUIRED, CHECK FOR STABILITY UNDERFOOT BEFORE STANDING ON IT.
9. PUBLIC - ACCESS - CONTRACTOR TO RESTRICT ACCESS TO SITE.
10. OBSTRUCTION - TIMBER STRUCTURES TO BE CUT DOWN OR REMOVED WHERE REQUIRED FOR SAFE COMPLETION OF THE WORKS
11. WALL DEFLECTIONS - CONTRACTOR TO MONITOR WALL DURING WORKS. CONTRACTOR TO ENSURE A SAFE CLEARANCE IS KEPT BETWEEN THE WALL AND EXCAVATOR TRACKS. IF EXCESSIVE MOVEMENTS ARE OBSERVED, STOP WORK IMMEDIATELY
12. ACCESS TO SITE WILL BE FAIRLY LIMITED.
13. OBSTRUCTION - EXISTING CABINS & BUILDINGS LOCATED NEARBY TO EXCAVATION WORKS. FOR CABINS, CONTRACTOR TO MANAGE ANY WORKS ASSOCIATED WITH TEMPORARY SUPPORT OR REMOVAL, STORAGE AND REINSTATEMENT IF REQUIRED FOR THE WORKS. FOR BUILDINGS, CONTRACTOR TO ENSURE SAFE CLEARANCE TO FOUNDATIONS AND ENSURE NO UNDERMINING OCCURS.
14. OBSTRUCTION - EXISTING TREE LOCATED NEARBY TO THE EXCAVATION WORKS. CONTRACTOR TO MANAGE ANY WORKS ASSOCIATED WITH TEMPORARY SUPPORT, IF REQUIRED FOR THE WORKS.
15. EXISTING SERVICES - POSSIBILITY OF UNFOUND SERVICES IN SAILING CLUB BUILDING AREA.

OPERATIONS & MAINTENANCE :-

16. SCOUR - MONITORING PLAN TO BE PUT IN PLACE WHICH IDENTIFIES CRITICAL LEVELS AT WHICH BEACH REINSTATEMENT MAY HAVE TO TAKE PLACE.
17. PERMISSIVE FOOTPATH - PERMISSIVE FOOTPATH PASSES OVER REVETMENT ROUNDHEAD. POSSIBLE SETTLEMENT ISSUES DUE TO SHINGLE INFILTRATION INTO ROCK VOIDS BELOW MAY CAUSE INSTABILITY.


ENVIRONMENTAL :-

18. SPILLS - CONTRACTOR TO ENSURE SPILL KITS AVAILABLE FOR THE APPROPRIATE RISK AND VOLUME. SUITABLE PPE SHOULD ALSO BE INCLUDED.
19. POLLUTION - ANY DEBRIS FOUND ON SITE / PLASTIC USED DURING THE WORKS TO BE RETRIEVED AND DISPOSED OF RESPONSIBLY. CONTRACTOR TO PLAN WORKS ACCORDINGLY SO THAT GROUTING IS DONE IN DRY CONDITIONS AND TO ENSURE THAT SUITABLE MEASURES ARE IMPLEMENTED TO PREVENT ANY SPILLAGES.
20. HABITAT LOSS - ACCESS TO PLANT AND PERSONNEL INTO THE LANDSCAPED AREAS IS ONLY PERMITTED FOR THE PURPOSE OF UNDERTAKING LANDSCAPING WORK.
21. WATER TURBIDITY - CONTRACTOR TO STRICTLY ADHERE TO ALLOWABLE WORKING WINDOW.

REFER TO GENERAL NOTES AND THE PRINCIPAL CONTRACTOR FOR MORE INFORMATION ABOUT THE RISKS ASSOCIATED WITH THIS WORK. IT IS ASSUMED THAT ALL WORKS WILL BE CARRIED OUT BY A COMPETENT CONTRACTOR WORKING, WHERE APPROPRIATE, TO AN APPROVED METHOD STATEMENT.

KEY TO HEALTH AND SAFETY SYMBOLS :-

- INDICATES A RESIDUAL RISK REQUIRING A COMPULSORY ACTION
- INDICATES A RESIDUAL RISK FOR INFORMATION
- INDICATES A RESIDUAL RISK REQUIRING A PROHIBITIVE ACTION
- INDICATES A RESIDUAL RISK AS A WARNING
- INDICATES AN ENVIRONMENTAL RISK

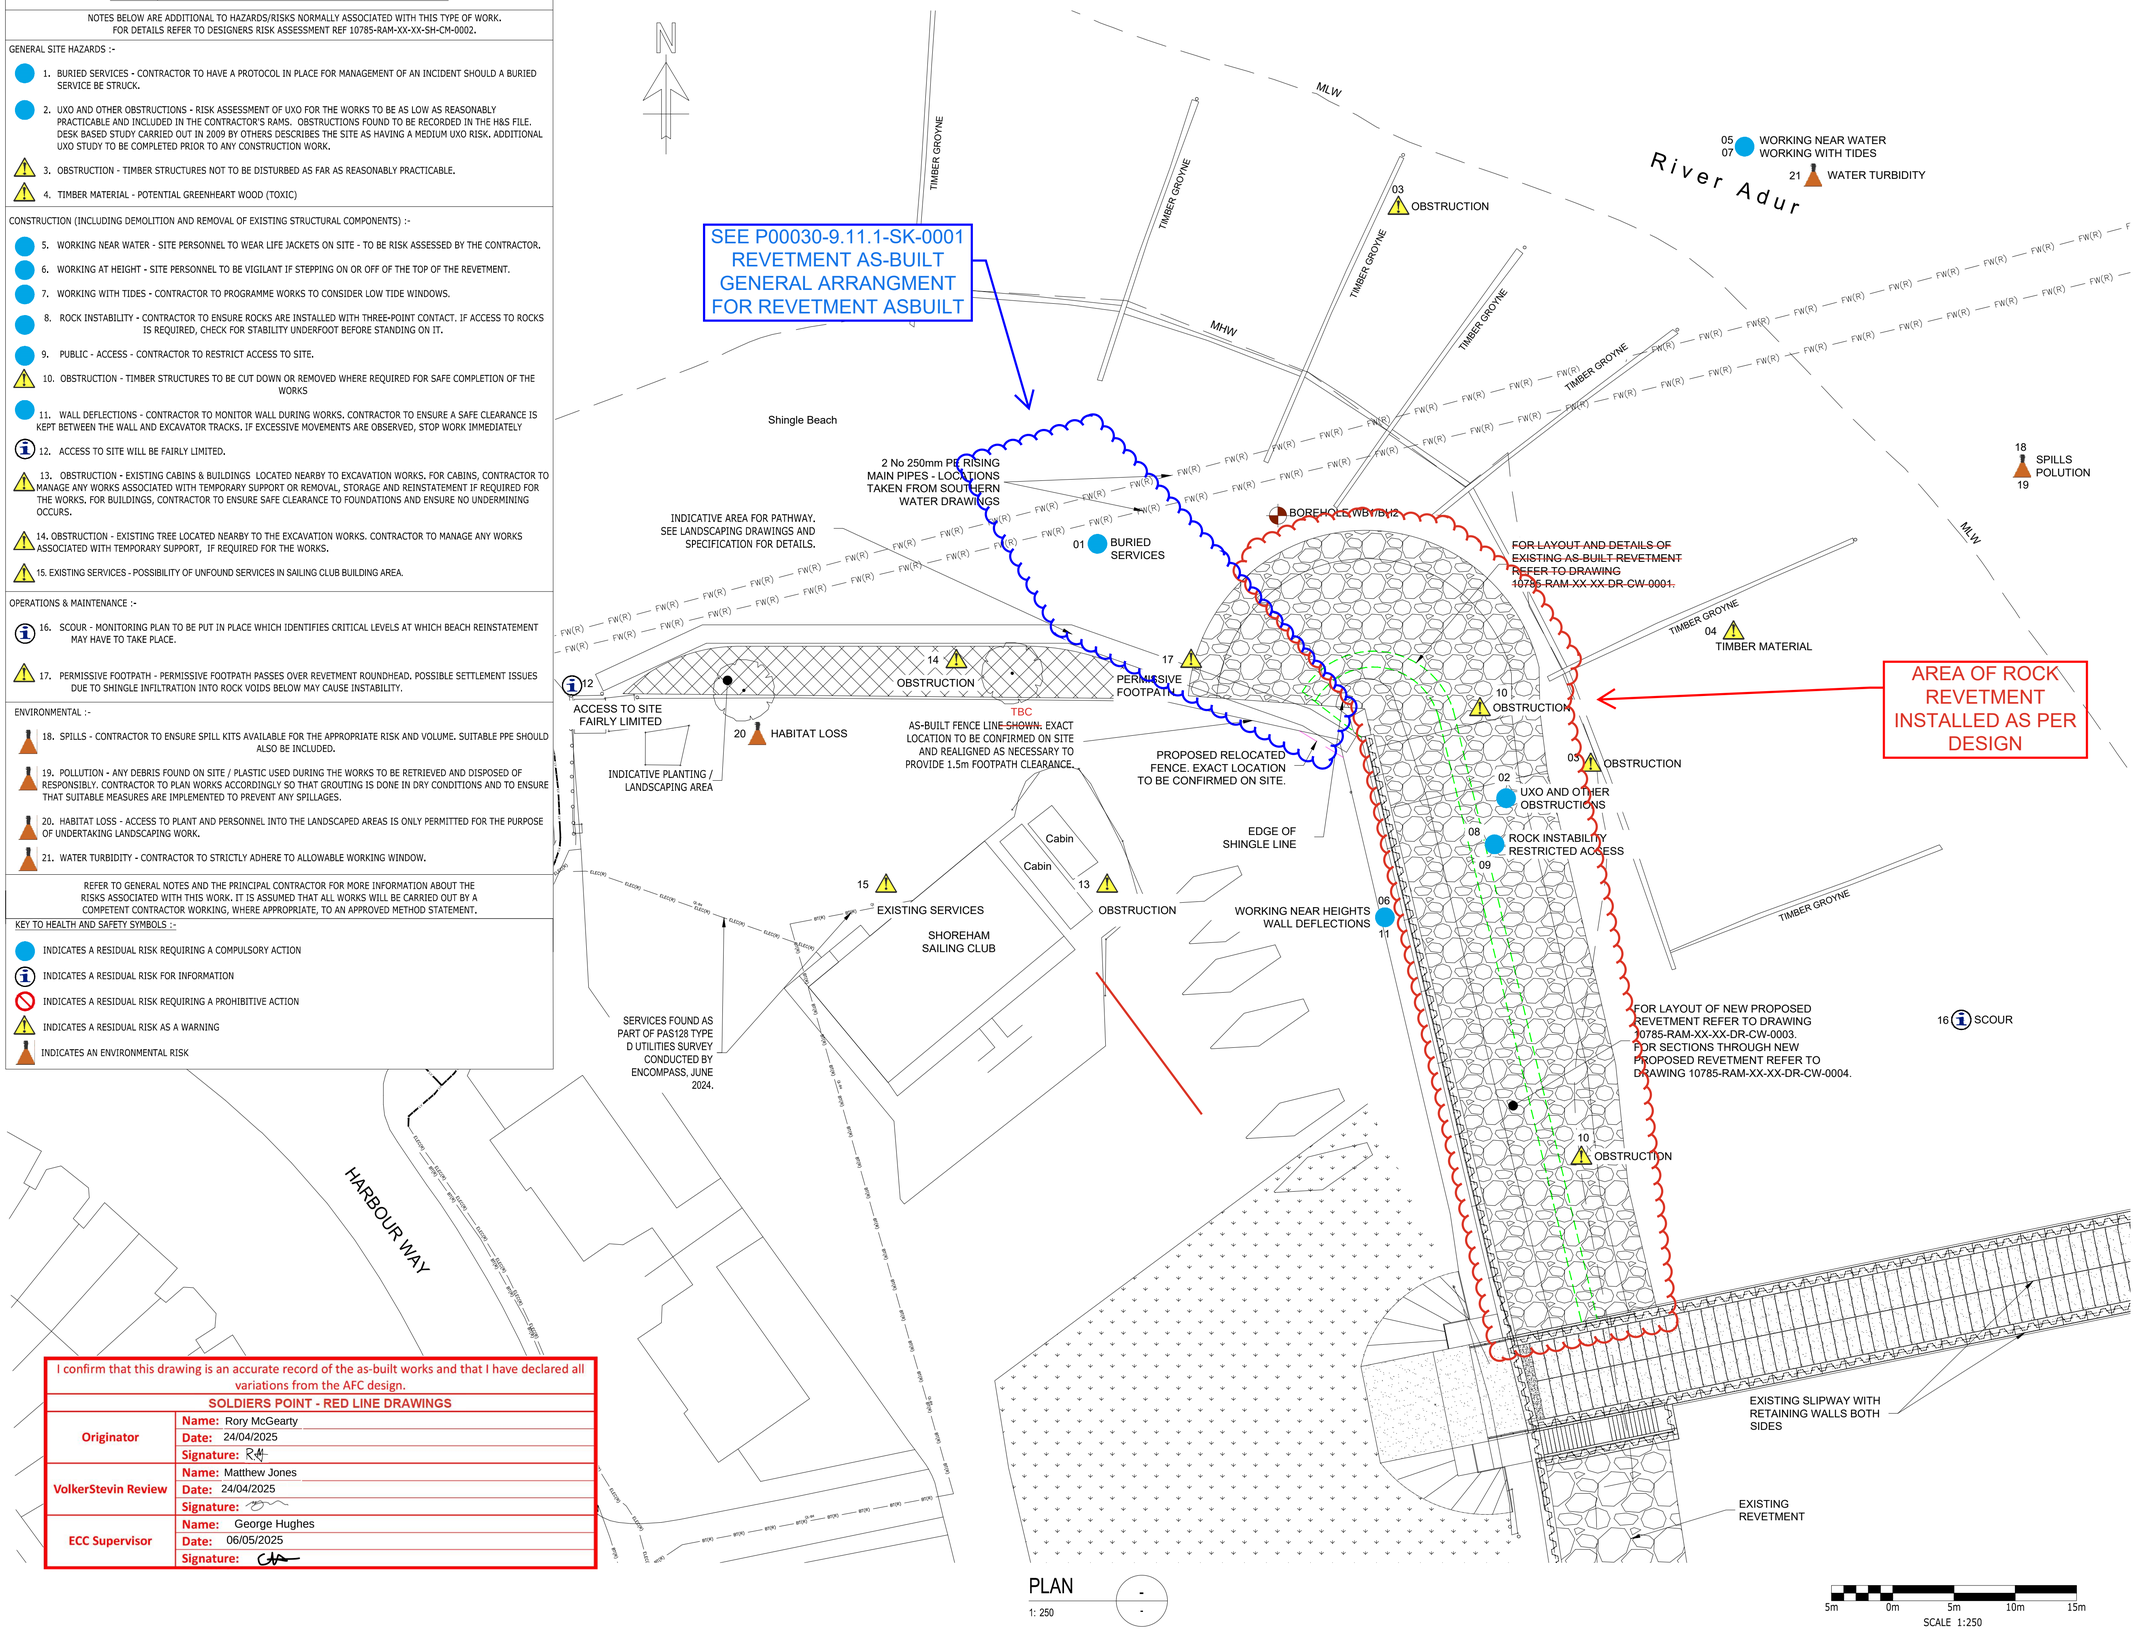


I confirm that this drawing is an accurate record of the as-built works and that I have declared all variations from the AFC design.	
SOLDIERS POINT - RED LINE DRAWINGS	
Originator	**Name:** Rory McGearty
	Date: 24/04/2025
	Signature: RM
VolkerStevin Review	**Name:** Matthew Jones
	Date: 24/04/2025
	Signature:
ECC Supervisor	**Name:** George Hughes
	Date: 06/05/2025
	Signature:

COPYRIGHT RAMBOLL UK LIMITED. ALL RIGHTS RESERVED. THIS DOCUMENT IS ISSUED FOR THE PARTY WHO COMMISSIONED IT AND FOR THE SPECIFIC PURPOSES CONNECTED WITH THE PROJECT ONLY. IT SHOULD NOT BE RELIED UPON BY ANY OTHER PARTY OR USED FOR ANY OTHER PURPOSE. RAMBOLL ACCEPTS NO RESPONSIBILITY OR LIABILITY WHICH MAY ARISE FROM RELIANCE OR USE OF THIS DOCUMENT OR THE DATA CONTAINED HEREIN BY ANY OTHER PARTY OR FOR ANY OTHER PURPOSE.

Notes

1. DO NOT SCALE FROM THIS DRAWING.
2. THIS DRAWING IS TO BE READ IN CONJUNCTION WITH ALL RELEVANT DRAWINGS AND SPECIFICATIONS.
3. ALL DIMENSIONS ARE IN MILLIMETRES U.N.O.
4. ALL CO-ORDINATES ARE IN METRES U.N.O.
5. BATHYMETRIC LEVELS IN METRES ABOVE CHART DATUM.
6. TOPOGRAPHICAL LEVELS IN METRES ABOVE ORDNANCE DATUM.
7. FOR THE RELATIONSHIP BETWEEN THE CHART DATUM AND ORDNANCE DATUM REFER TO THE TABLE BELOW:

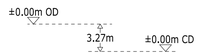

TIDAL LEVELS

DESCRIPTION	LEVEL (mCD)	LEVEL (mOD)
HIGHEST ASTRONOMICAL TIDE (HAT)	+6.90m	+3.63m
MEAN HIGH WATER SPRINGS (MHWS)	+6.33m	+3.06m
MEAN HIGH WATER NEAPS (MHWN)	+4.80m	+1.53m
MEAN LOW WATER NEAPS (MLWN)	+1.90m	-1.37m
MEAN LOW WATER SPRINGS (MLWS)	+0.60m	-2.67m
LOWEST ASTRONOMICAL TIDE (LAT)	-0.10m	-3.17m

8. ALL MAP IMAGES COPYRIGHT OF THE ORDNANCE SURVEY.
9. FOR CONSTRUCTION SEQUENCE AND SITE CONTRAINTS REFER TO DRAWING 10785-RAM-XX-XX-DR-CW-0005.
10. FOR SETTING OUT OF NEW PROPOSED REVETMENT REFER TO DRAWING 10785-RAM-XX-XX-DR-CW-0006.

RL01 REDLINE 24/04/2025 RMcG MJ

Rev	Description	Date	By / Chk	App
A3	CONSTRUCTION ISSUE INCORPORATING CHANGES IN FORMATION LEVEL AND ROUNDHEAD EXTENT	20/02/2025	TRP / BP	MO
A2	CONSTRUCTION ISSUE	13/02/2025	TRP / BP	MO
A1	CONSTRUCTION ISSUE	30/09/2024	TRP / CRL	MO
P06	FOR DESIGN FREEZE	06/10/2023	NNP / BP	MO
P05	FOR DESIGN FREEZE	05/10/2023	NNP / BP	MO
P04	FOR DESIGN FREEZE	25/09/2023	NNP / BP	MO
P03	REVISED AS CLOUDED	19/06/2023	NNP / BP	MO
P02	REVISED AS CLOUDED	14/04/2023	SPF / BP	MO
P01	PRELIMINARY ISSUE	03/03/2023	SPF / BP	MO

REDLINE

SHOREHAM ADUR TIDAL WALLS W1 SOLDIERS POINT REMEDIAL WORKS

JBA consulting
Environment Agency
RAMBOLL
tel 023 8081 7500 southampton@ramboll.co.uk
www.ramboll.co.uk

GENERAL ARRANGEMENT PLAN

Project No:	Scale (@A1):	Drawn:	Date:
1620010785	1:250	TRP	24/04/25
Drawing No:			Rev:
10785-RAM-XX-XX-DR-CW-0002			RL01

19/02/2025 13:04:44