
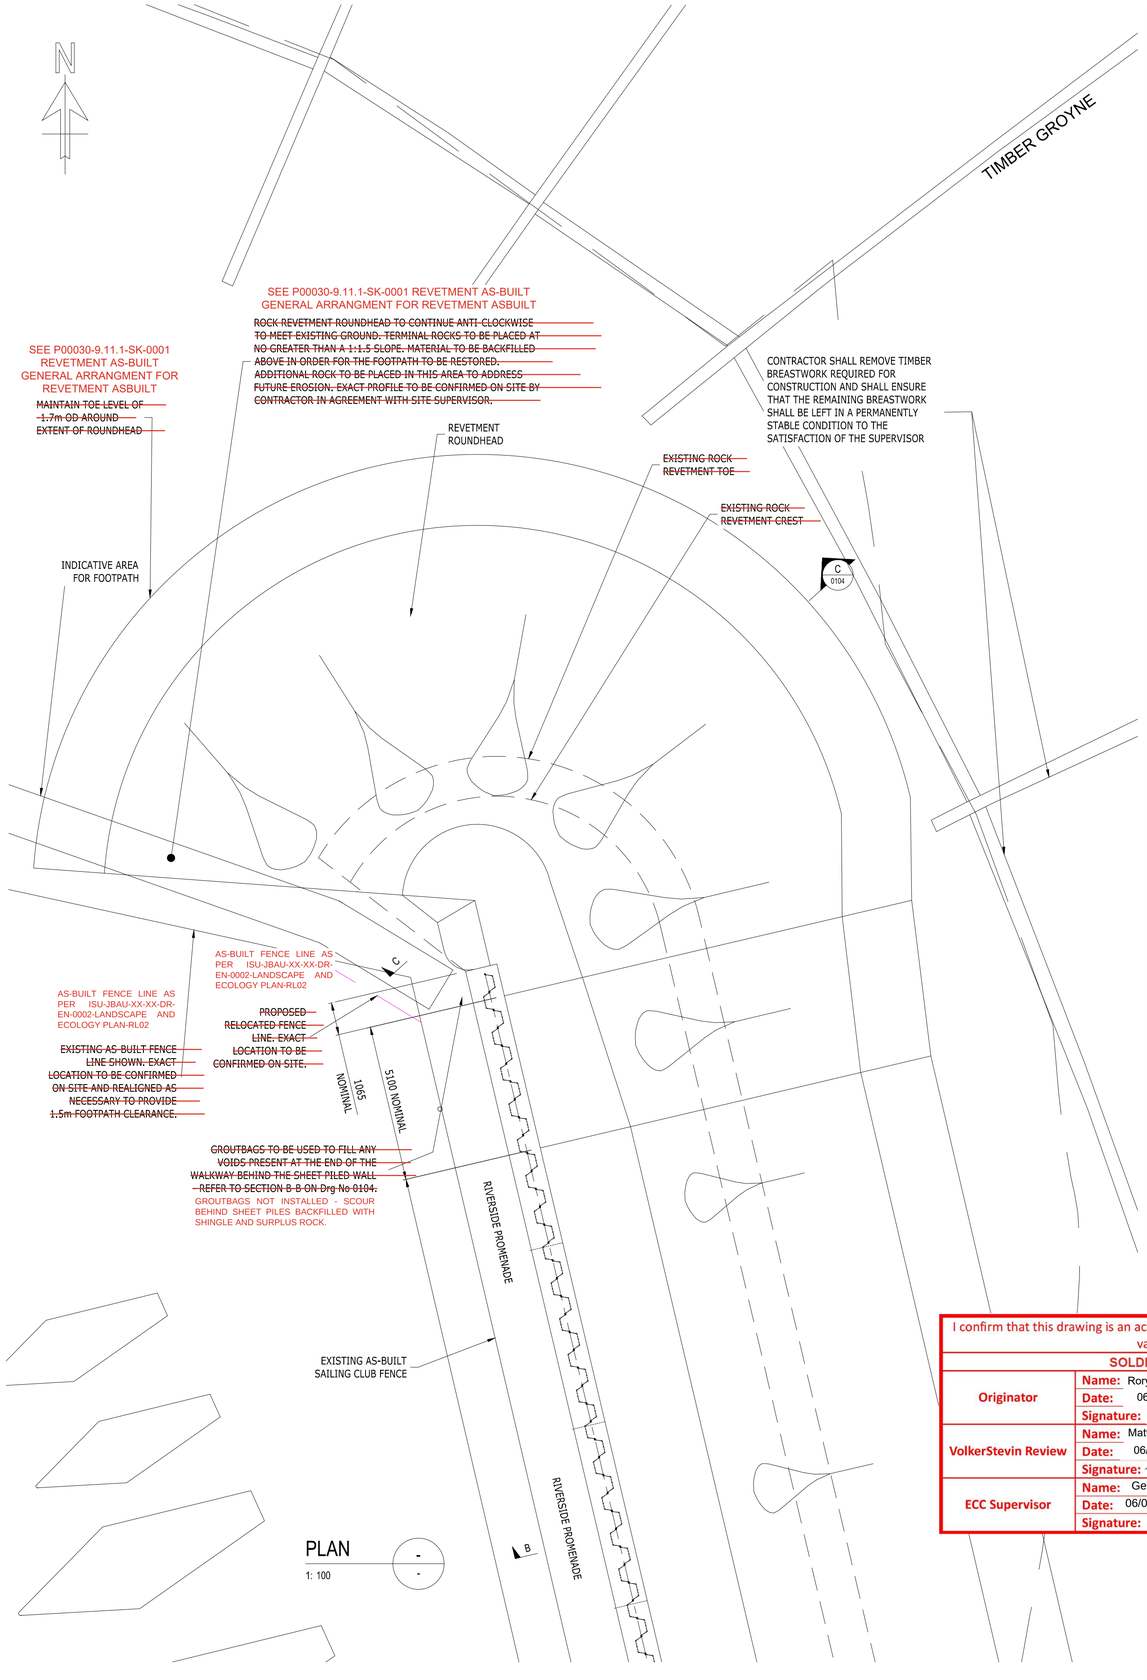


PLAN 1: 100

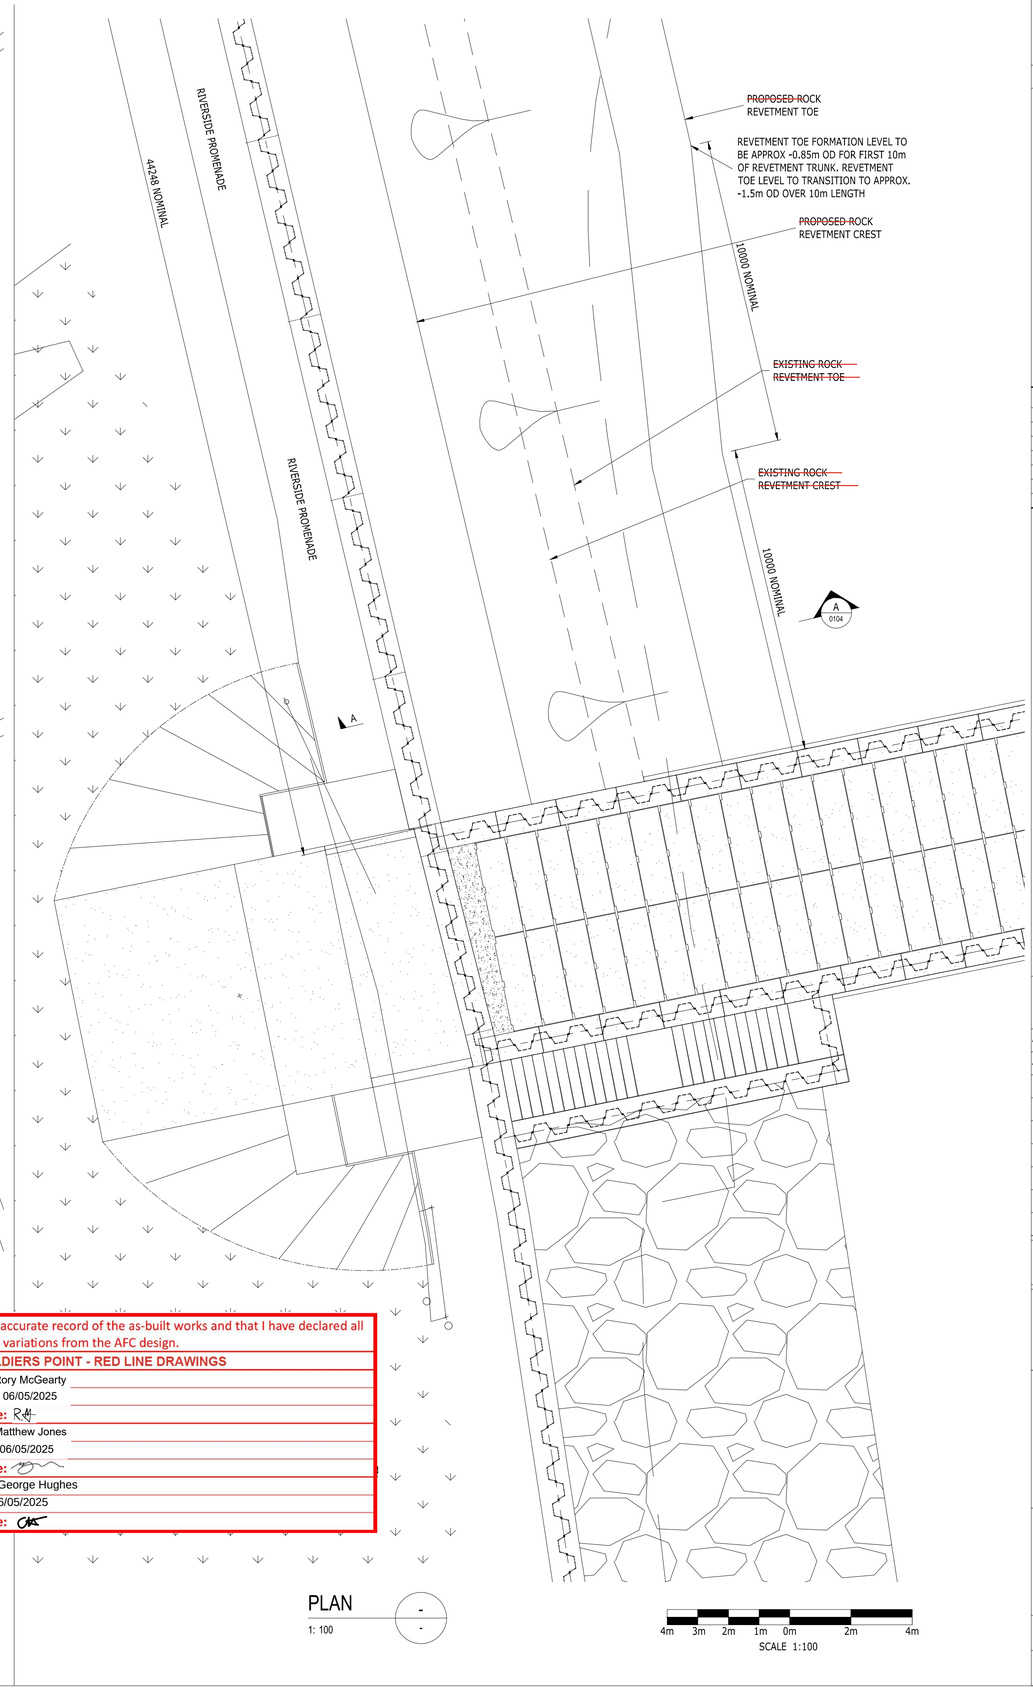

PLAN 1: 100

4m 3m 2m 1m 0m 2m 4m
SCALE 1:100

I confirm that this drawing is an accurate record of the as-built works and that I have declared all variations from the AFC design.

SOLDIERS POINT - RED LINE DRAWINGS		
Originator	Name:	Rory McGearty
	Date:	06/05/2025
	Signature:	RM
VolkerStevin Review	Name:	Matthew Jones
	Date:	06/05/2025
	Signature:	
ECC Supervisor	Name:	George Hughes
	Date:	06/05/2025
	Signature:	

COPYRIGHT RAMBOLL UK LIMITED. ALL RIGHTS RESERVED. THIS DOCUMENT IS ISSUED FOR THE PARTY WHO COMMISSIONED IT AND FOR THE SPECIFIC PURPOSES CONNECTED WITH THE PROJECT ONLY. IT SHOULD NOT BE RELIED UPON BY ANY OTHER PARTY OR USED FOR ANY OTHER PURPOSE. RAMBOLL ACCEPTS NO RESPONSIBILITY OR LIABILITY WHICH MAY ARISE FROM RELIANCE OR USE OF THIS DOCUMENT OR THE DATA CONTAINED HEREIN BY ANY OTHER PARTY OR FOR ANY OTHER PURPOSE.

Notes

1. DO NOT SCALE FROM THIS DRAWING.
2. THIS DRAWING IS TO BE READ IN CONJUNCTION WITH ALL RELEVANT DRAWINGS AND SPECIFICATIONS.
3. ALL DIMENSIONS ARE IN MILLIMETRES U.N.O.
4. ALL CO-ORDINATES ARE IN METRES U.N.O.
5. BATHYMETRIC LEVELS IN METRES ABOVE CHART DATUM.
6. TOPOGRAPHICAL LEVELS IN METRES ABOVE ORDNANCE DATUM.
7. FOR THE RELATIONSHIP BETWEEN THE CHART DATUM AND ORDNANCE DATUM REFER TO THE TABLE BELOW:



TIDAL LEVELS

DESCRIPTION	LEVEL (mCD)	LEVEL (mOD)
HIGHEST ASTRONOMICAL TIDE (HAT)	+6.90m	+3.63m
MEAN HIGH WATER SPRINGS (MHWS)	+6.33m	+3.06m
MEAN HIGH WATER NEAPS (MHWN)	+4.80m	+1.53m
MEAN LOW WATER NEAPS (MLWN)	+1.90m	-1.37m
MEAN LOW WATER SPRINGS (MLWS)	+0.60m	-2.67m
LOWEST ASTRONOMICAL TIDE (LAT)	-0.10m	-3.17m

8. ALL MAP IMAGES COPYRIGHT OF THE ORDNANCE SURVEY.
9. FOR SAFETY, HEALTH & ENVIRONMENTAL INFORMATION REFER TO DRAWING :- 10785-RAM-XX-XX-DR-CW-0002.

Rev	Description	Date	By	Chk	App
RL02	UPDATED IN LINE WITH G.H COMMENTS	06/05/2025	RMcG	MJ	
RL01	REDLINE	24/04/2025	RMcG	MJ	
A3	CONSTRUCTION ISSUE INCORPORATING CHANGES IN FORMATION LEVEL AND ROUNDHEAD EXTENT	20/02/2025	TRP	BP	MO
A2	CONSTRUCTION ISSUE	13/02/2025	TRP	BP	MO
A1	CONSTRUCTION ISSUE	30/09/2024	TRP	CRL	MO
P06	FOR DESIGN FREEZE	05/10/2023	NNP	BP	MO
P05	FOR DESIGN FREEZE	25/09/2023	NNP	BP	MO
P04	REVISED AS CLOUDED	19/06/2023	NNP	BP	MO
P03	REVISED AS CLOUDED	14/04/2023	SPF	BP	MO
P02	PRELIMINARY ISSUE	15/03/2023	SPF	BP	MO
P01	PRELIMINARY ISSUE	03/03/2023	SPF	BP	MO

REDLINE

SHOREHAM ADUR TIDAL WALLS W1 SOLDIERS POINT REMEDIAL WORKS

JBA consulting
Environment Agency
RAMBOLL
tel 023 8081 7500 southampton@ramboll.co.uk
www.ramboll.co.uk

PROPOSED REVETMENT LAYOUT

Project No:	Scale (@A1):	Drawn:	Date:
1620010785	1:100	TRP	06/05/25

Drawing No: 10785-RAM-XX-XX-DR-CW-0003
Rev: RL02

19/02/2025 13:12:32