
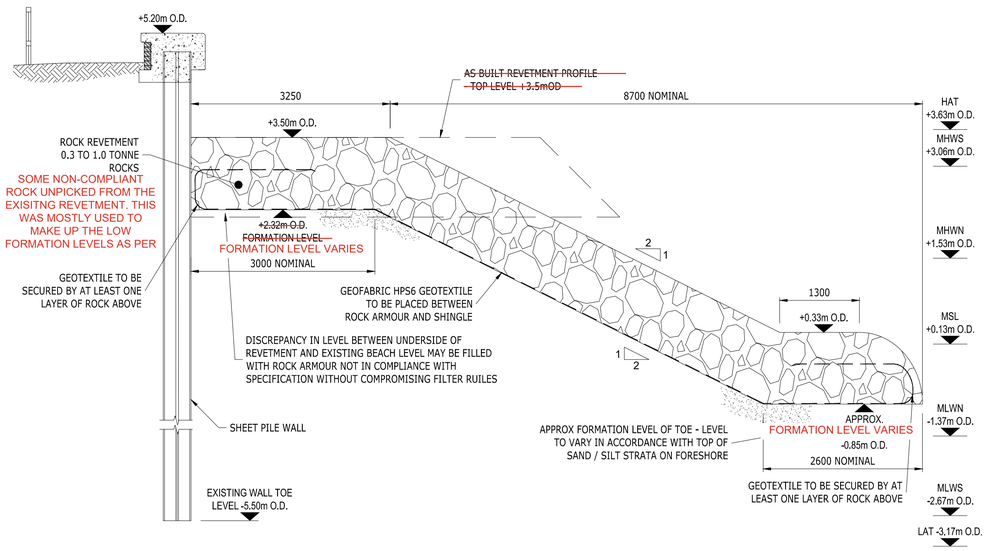


SECTION A-A (0003)
1: 50

REVETMENT TRUNK TYPICAL SECTION - FIRST 10M


SEE DRAWING P00030-9.11.1-SK0001 & 0002 FOR SECTION AS-BUILT

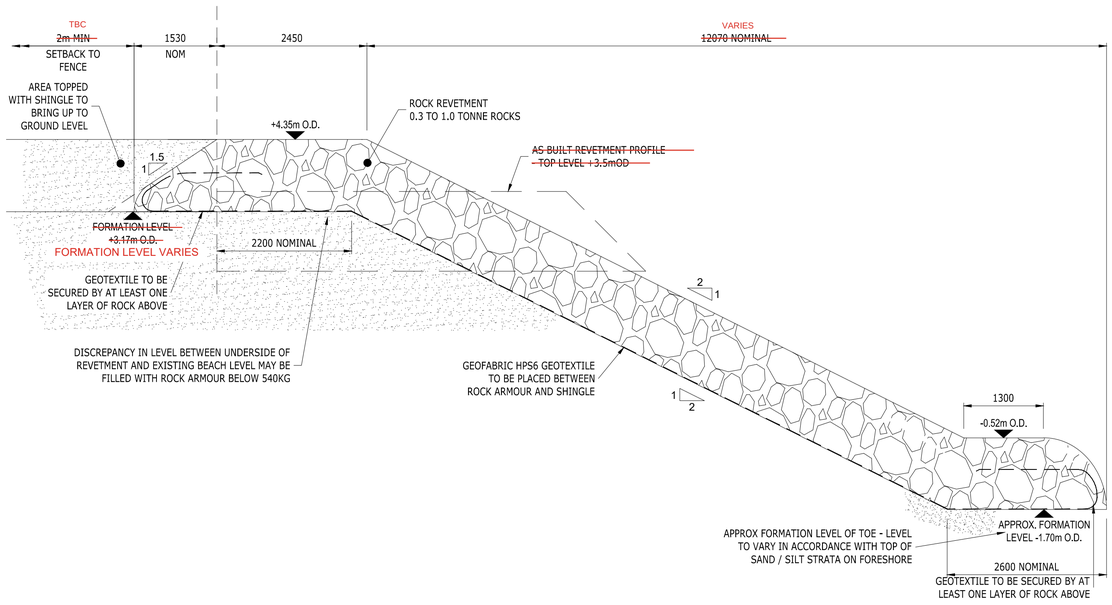

SECTION C-C (0003)
1: 50

REVETMENT ROUNDHEAD TYPICAL SECTION

SEE DRAWING P00030-9.11.1-SK0001, 0005 & 0006 FOR SECTION AS-BUILT

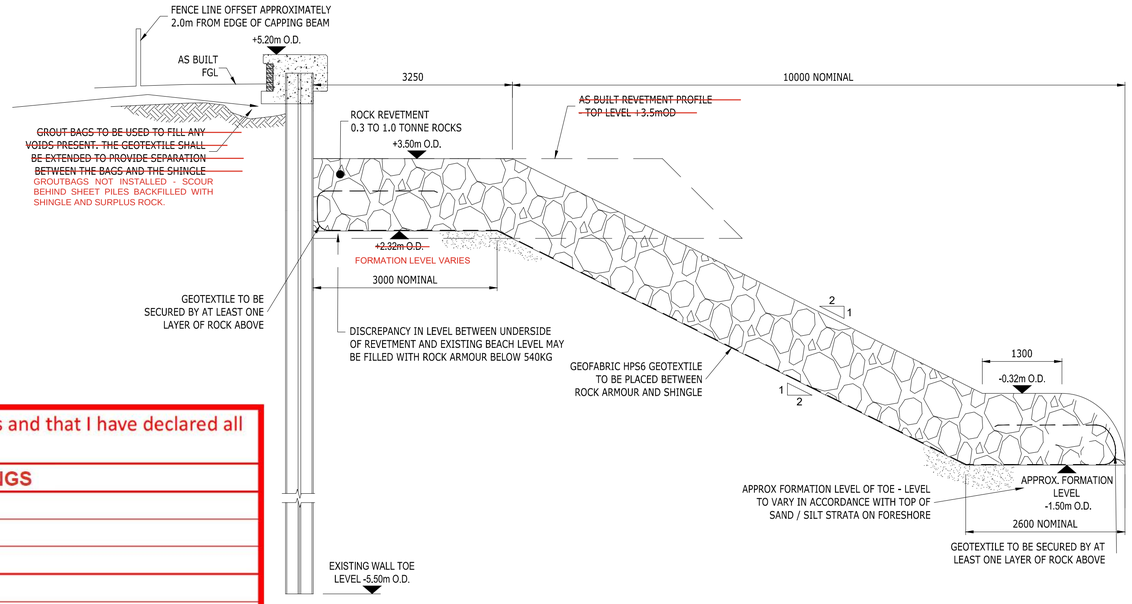

PHOTOGRAPH AT END OF EXISTING RETAINING WALL SHOWING TYPICAL VOIDS UNDERNEATH

SECTION B-B (0003)
1: 50

REVETMENT TRUNK TYPICAL SECTION - REMAINING TRUNK LENGTH

SEE DRAWING P00030-9.11.1-SK0001, 0003 & 0004 FOR SECTION AS-BUILT


24/04/25

I confirm that this drawing is an accurate record of the as-built works and that I have declared all variations from the AFC design.		
SOLDIERS POINT - RED LINE DRAWINGS		
Originator	**Name:**	Rory McGearty
	Date:	06/05/2025
	Signature:	R.M.
VolkerStevin Review	**Name:**	Matthew Jones
	Date:	06/05/2025
	Signature:	
ECC Supervisor	**Name:**	George Hughes
	Date:	06/05/2025
	Signature:	

COPYRIGHT RAMBOLL UK LIMITED. ALL RIGHTS RESERVED. THIS DOCUMENT IS ISSUED FOR THE PARTY WHO COMMISSIONED IT AND FOR THE SPECIFIC PURPOSES CONNECTED WITH THE PROJECT ONLY. IT SHOULD NOT BE RELIED UPON BY ANY OTHER PARTY OR USED FOR ANY OTHER PURPOSE. RAMBOLL ACCEPTS NO RESPONSIBILITY OR LIABILITY WHICH MAY ARISE FROM RELIANCE OR USE OF THIS DOCUMENT OR THE DATA CONTAINED HEREIN BY ANY OTHER PARTY OR FOR ANY OTHER PURPOSE.

Notes

1. DO NOT SCALE FROM THIS DRAWING.
2. THIS DRAWING IS TO BE READ IN CONJUNCTION WITH ALL RELEVANT DRAWINGS AND SPECIFICATIONS.
3. ALL DIMENSIONS ARE IN MILLIMETRES U.N.O.
4. ALL CO-ORDINATES ARE IN METRES U.N.O.
5. BATHYMETRIC LEVELS IN METRES ABOVE CHART DATUM.
6. TOPOGRAPHICAL LEVELS IN METRES ABOVE ORDNANCE DATUM.
7. FOR THE RELATIONSHIP BETWEEN THE CHART DATUM AND ORDNANCE DATUM REFER TO THE TABLE BELOW:

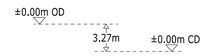

TIDAL LEVELS

DESCRIPTION	LEVEL (mCD)	LEVEL (mOD)
HIGHEST ASTRONOMICAL TIDE (HAT)	+6.90m	+3.63m
MEAN HIGH WATER SPRINGS (MHWS)	+6.33m	+3.06m
MEAN HIGH WATER NEAPS (MHWN)	+4.80m	+1.53m
MEAN LOW WATER NEAPS (MLWN)	+1.90m	-1.37m
MEAN LOW WATER SPRINGS (MLWS)	+0.60m	-2.67m
LOWEST ASTRONOMICAL TIDE (LAT)	-0.10m	-3.17m

8. ALL MAP IMAGES COPYRIGHT OF THE ORDNANCE SURVEY.
9. FOR SAFETY, HEALTH & ENVIRONMENTAL INFORMATION REFER TO DRAWING :- 10785-RAM-XX-XX-DR-CW-0002.

Rev	Description	Date	By / Chk	App
RL02	REDLINE	06/05/2025	RMcG / MJ	
RL01	REDLINE	24/04/2025	RMcG / MJ	
A3	CONSTRUCTION ISSUE INCORPORATING CHANGES IN FORMATION LEVEL AND ROUNDHEAD EXTENT	20/02/2025	TRP / BP	MO
A2	CONSTRUCTION ISSUE	13/02/2025	TRP / BP	MO
A1	CONSTRUCTION ISSUE	30/09/2024	TRP / CRL	MO
P05	FOR DESIGN FREEZE	25/09/2023	NNP / BP	MO
P04	REVISED AS CLOUDED	19/06/2023	NNP / BP	MO
P03	REVISED AS CLOUDED	14/04/2023	SPF / BP	MO
P02	PRELIMINARY ISSUE	15/03/2023	SPF / BP	MO
P01	PRELIMINARY ISSUE	03/03/2023	SPF / BP	MO

REDLINE

SHOREHAM ADUR TIDAL WALLS
W1 SOLDIERS POINT
REMEDIAL WORKS

JBA consulting
Environment Agency
RAMBOLL

tel 023 8081 7500 southampton@ramboll.co.uk
www.ramboll.co.uk

PROPOSED REVETMENT SECTIONS

1m 0m 1m 2m 3m
SCALE 1:50

Project No:	Scale (@A1):	Drawn:	Date:
1620010785	As noted	TRP	06/05/2025

Drawing No: 10785-RAM-XX-XX-DR-CW-0004 Rev: RL02

19/02/2025 13:17:36