
PRELIMINARY CONSTRUCTION SEQUENCE :-

1. REMOVAL OF EXISTING ROUNDHEAD AND PART OF THE TRUNK AT THE NORTH END OF THE ROCK REVETMENT. TIMBER POSTS AND BREASTWORK TO BE REMOVED WHERE REQUIRED FOR SAFE COMPLETION OF THE WORKS.
2. REMOVAL OF FIRST SEGMENT OF ROCK AT INTERFACE WITH SLIPWAY (APPROXIMATELY 10M WIDE SEGMENT).
3. REMOVAL OF EXISTING REVETMENT AND CONSTRUCTION OF NEW REVETMENT ALONG THE TRUNK OF THE REVETMENT IN SEGMENTS (APPROXIMATELY 20M IN WIDTH) MAIN UNTIL TRANSITION TO ROUNDHEAD IS REACHED.
   - IN SITU BEACH MATERIAL TO BE RE-LEVELLED AS REQUIRED TO BUILD THE FORMATION LEVEL OF THE NEW REVETMENT.
   - WORKS ON THE TRUNK OF THE REVETMENT SHOULD BE SUITABLY COMPLETED PRIOR TO CONSTRUCTING TRANSITION ZONE AND ROUNDHEAD AS ACCESS TO THE BEACH BECOMES RESTRICTED AGAIN.
4. ANY VOIDS FOUND UNDER FOOTPATH AT THE NORTH END OF SHEET PILE ~~TO BE FILLED WITH GROUT BAGS.~~ BACKFILLED WITH SHINGLE AND SURPLUS ROCK.
5. CONSTRUCTION OF TRANSITION ZONE, EXCAVATION AND TEMPORARY WORKS SUPPORT FOR EXCAVATIONS TO FORM ROUNDHEAD, AND CONSTRUCTION OF ROUNDHEAD.
6. BEACH LEVELS TO BE REINSTATED TO LEVELS BEFORE THE WORKS, AS NECESSARY
7. FINISHING WORKS, INCLUDING LANDSCAPING, THE PERMISSIVE FOOTPATH AND FENCING LAYOUT.

I confirm that this drawing is an accurate record of the as-built works and that I have declared all variations from the AFC design.

SOLDIERS POINT - RED LINE DRAWINGS

Originator	**Name:**	Rory McGearty
	Date:	06/05/2025
	Signature:	RMcG
VolkerStevin Review	**Name:**	Matthew Jones
	Date:	06/05/2025
	Signature:	
ECC Supervisor	**Name:**	George Hughes
	Date:	06/05/2025
	Signature:	

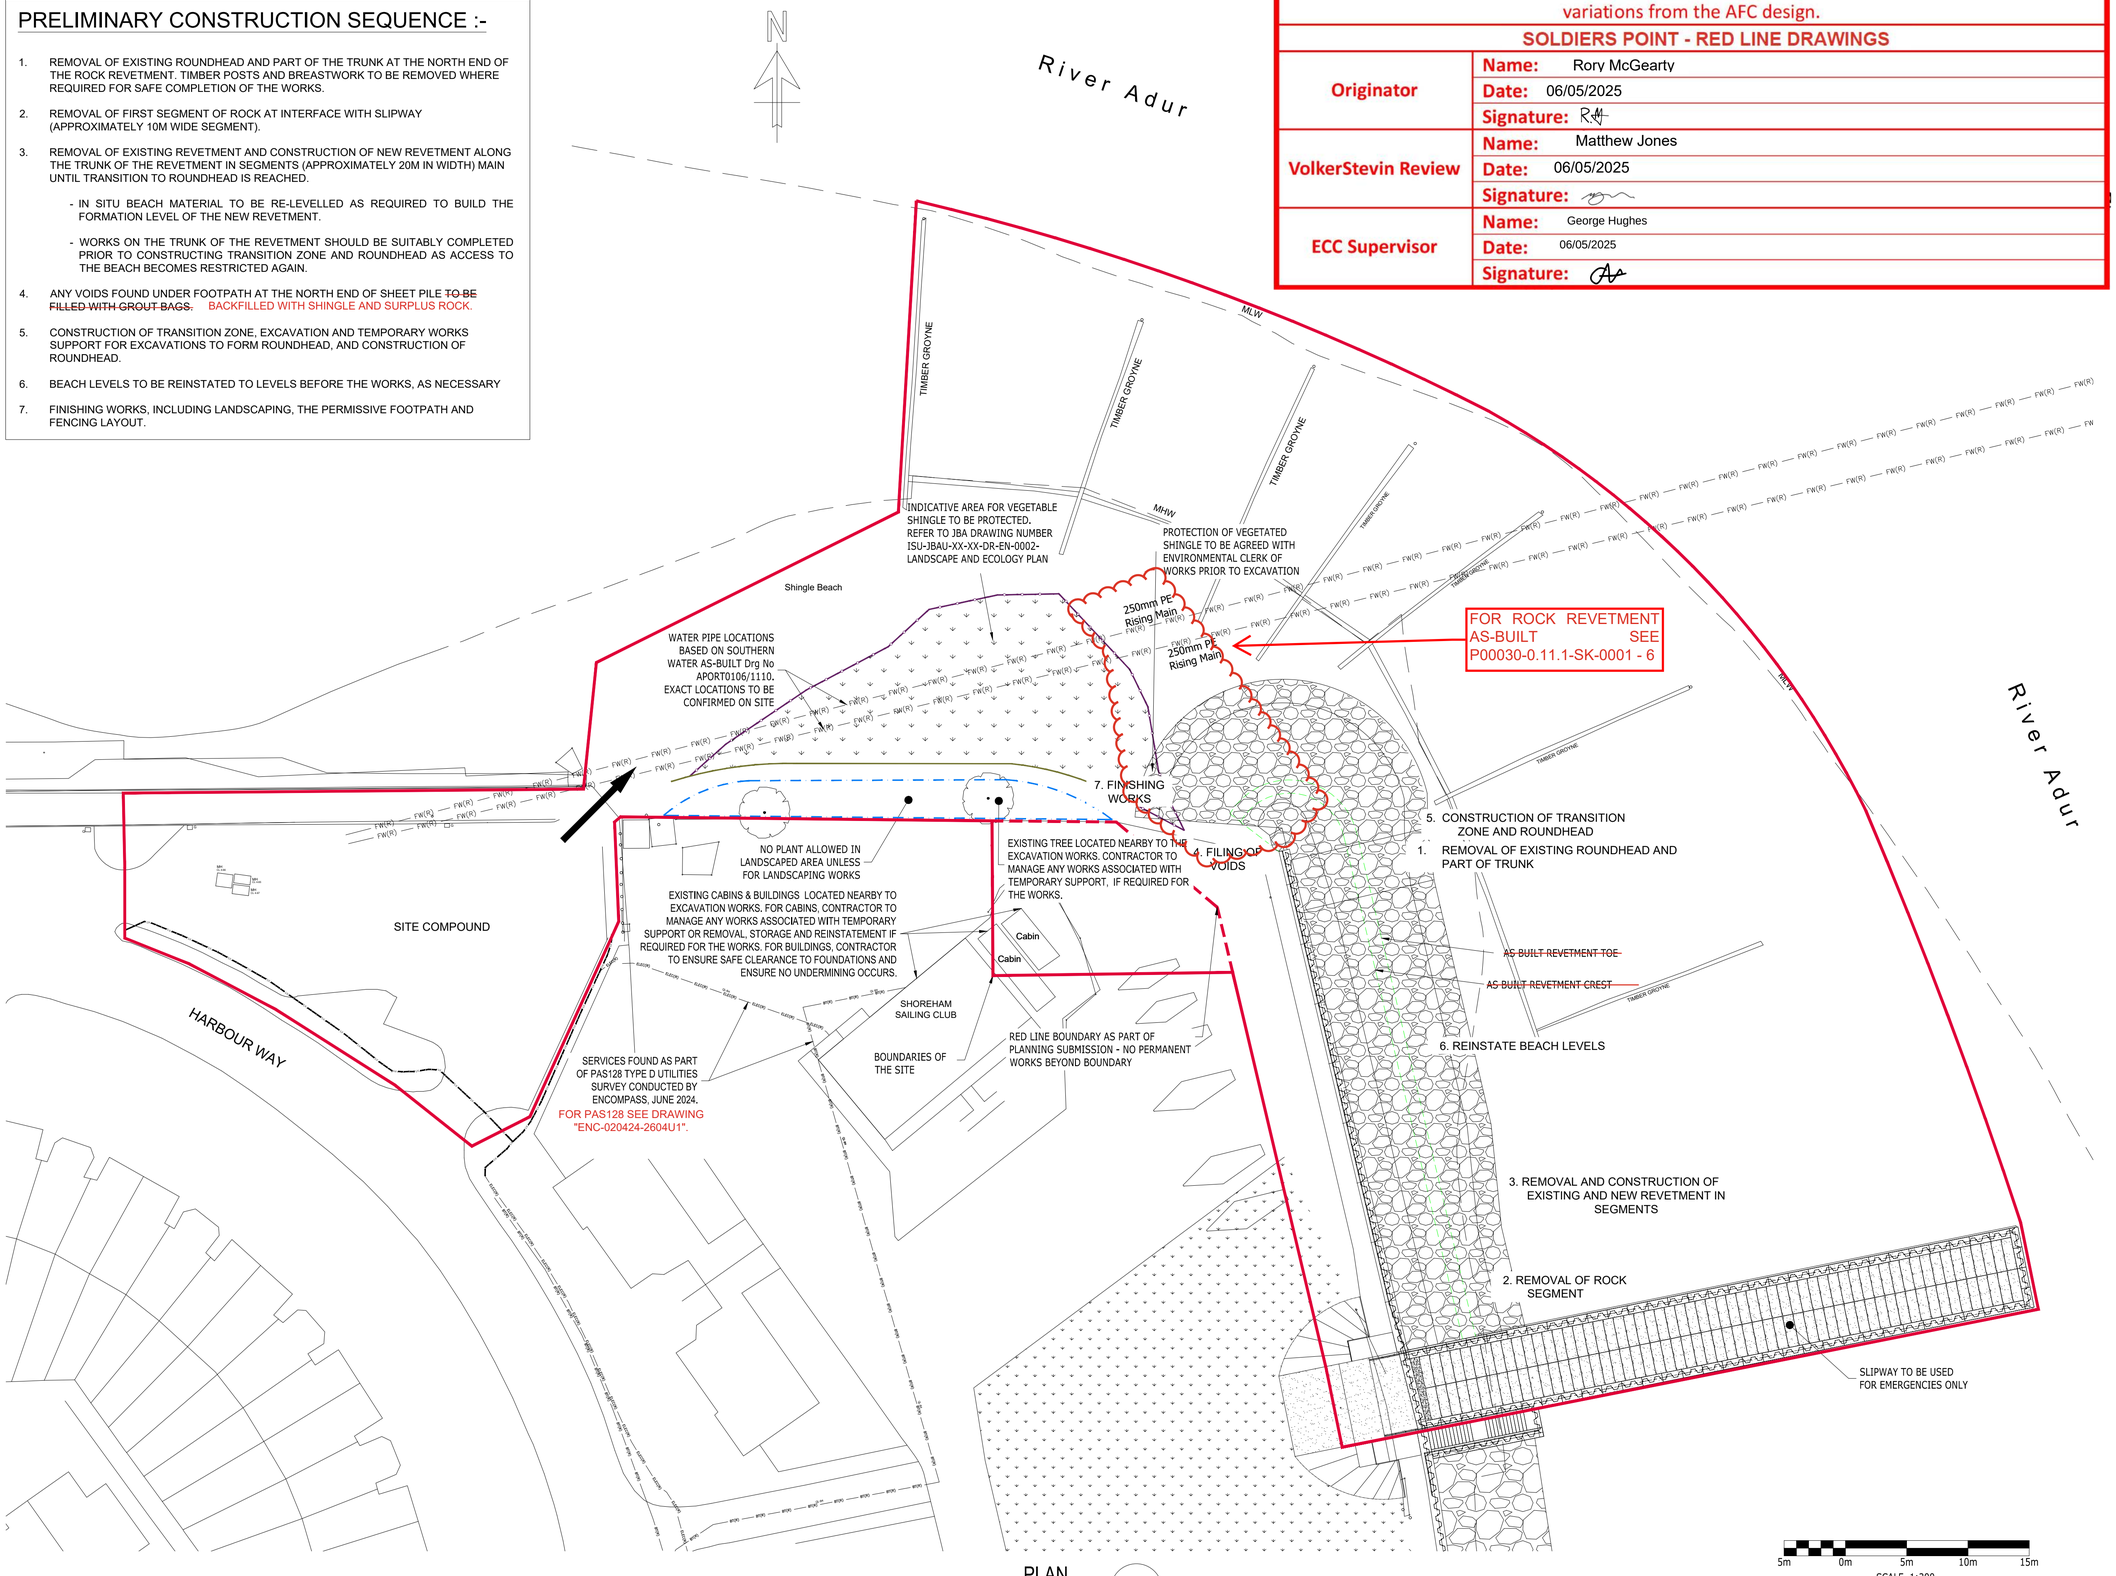

PLAN -
1: 300 -

COPYRIGHT RAMBOLL UK LIMITED. ALL RIGHTS RESERVED. THIS DOCUMENT IS ISSUED FOR THE PARTY WHO COMMISSIONED IT AND FOR THE SPECIFIC PURPOSES CONNECTED WITH THE PROJECT ONLY. IT SHOULD NOT BE RELIED UPON BY ANY OTHER PARTY OR USED FOR ANY OTHER PURPOSE. RAMBOLL ACCEPTS NO RESPONSIBILITY OR LIABILITY WHICH MAY ARISE FROM RELIANCE OR USE OF THIS DOCUMENT OR THE DATA CONTAINED HEREIN BY ANY OTHER PARTY OR FOR ANY OTHER PURPOSE.

Notes

1. DO NOT SCALE FROM THIS DRAWING.
2. THIS DRAWING IS TO BE READ IN CONJUNCTION WITH ALL RELEVANT DRAWINGS AND SPECIFICATIONS.
3. ALL DIMENSIONS ARE IN MILLIMETRES U.N.O.
4. ALL CO-ORDINATES ARE IN METRES U.N.O.
5. BATHYMETRIC LEVELS IN METRES ABOVE CHART DATUM.
6. TOPOGRAPHICAL LEVELS IN METRES ABOVE ORDNANCE DATUM.
7. FOR THE RELATIONSHIP BETWEEN THE CHART DATUM AND ORDNANCE DATUM REFER TO THE TABLE BELOW:

±0.00m OD
3.27m
±0.00m CD

TIDAL LEVELS

DESCRIPTION	LEVEL (mCD)	LEVEL (mOD)
HIGHEST ASTRONOMICAL TIDE (HAT)	+6.90m	+3.63m
MEAN HIGH WATER SPRINGS (MHWS)	+6.33m	+3.06m
MEAN HIGH WATER NEAPS (MHWN)	+4.80m	+1.53m
MEAN LOW WATER NEAPS (MLWN)	+1.90m	-1.37m
MEAN LOW WATER SPRINGS (MLWS)	+0.60m	-2.67m
LOWEST ASTRONOMICAL TIDE (LAT)	-0.10m	-3.17m

8. ALL MAP IMAGES COPYRIGHT OF THE ORDNANCE SURVEY.
9. FOR SAFETY, HEALTH & ENVIRONMENTAL INFORMATION REFER TO DRAWING :- 10785-RAM-XX-XX-DR-CW-0002.

KEY :-
- BOUNDARIES OF THE SITE
- INDICATIVE LANDSCAPED AREA

Rev	Description	Date	By	Chk	App
RL02	UPDATED IN LINE WITH GH COMMENTS	06/05/2025	RMcG	MJ	
RL01	REDLINE	24/04/2025	RMcG	MJ	
A3	CONSTRUCTION ISSUE INCORPORATING CHANGES IN FORMATION LEVEL AND ROUNDHEAD EXTENT	20/02/2025	TRP	BP	MO
A2	CONSTRUCTION ISSUE	13/02/2025	TRP	BP	MO
A1	CONSTRUCTION ISSUE	30/09/2024	TRP	CRL	MO
P10	FOR DESIGN FREEZE	27/03/2024	SPF	BP	MO
P09	FOR DESIGN FREEZE	18/10/2023	NNP	BP	MO
P08	FOR DESIGN FREEZE	25/09/2023	NNP	BP	MO
P07	REVISED AS CLOUDED	19/07/2023	NNP	BP	MO
P06	REVISED AS CLOUDED	13/07/2023	NNP	BP	MO
P05	REVISED AS CLOUDED	23/06/2023	NNP	BP	MO
P04	REVISED AS CLOUDED	19/06/2023	NNP	BP	MO
P03	REVISED AS CLOUDED	14/04/2023	SPF	BP	MO
P02	PRELIMINARY ISSUE	15/03/2023	SPF	BP	MO
P01	PRELIMINARY ISSUE	03/03/2023	SPF	BP	MO

REDLINE

SHOREHAM ADUR TIDAL WALLS
W1 SOLDIERS POINT
REMEDIAL WORKS

JBA consulting
Environment Agency
RAMBOLL
tel 023 8081 7500 southampton@ramboll.co.uk
www.ramboll.co.uk

CONSTRUCTION SEQUENCE AND SITE CONTRAINTS

Project No:	Scale (@A1):	Drawn:	Date:
1620010785	1:300	TRP	06/05/25

Drawing No: 10785-RAM-XX-XX-DR-CW-0005 Rev: RL02

20/02/2025 11:52:18