

FRONT EAST ELEVATION
PROPOSED ELEVATIONS
Scale 1:100

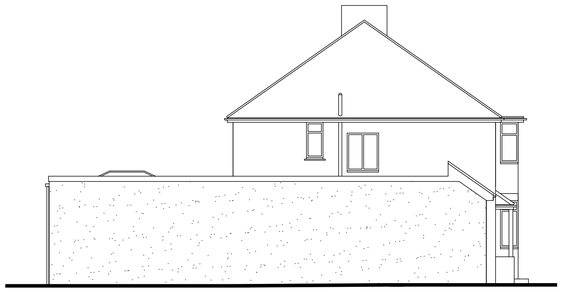

SIDE SOUTH ELEVATION



REAR WEST ELEVATION

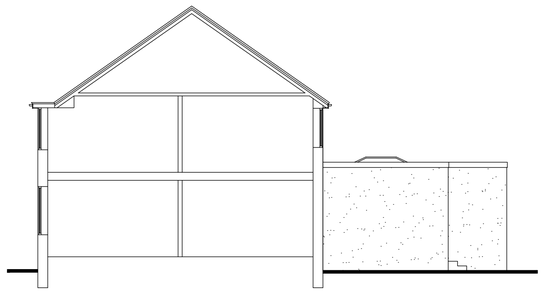

SIDE NORTH ELEVATION

0m 5m 10m

Scale Bar – 1:100

SCHEDULE OF MATERIALS - GROUND FLOOR REAR & SIDE EXTENSIONS
WALLS - SMOOTH RENDER TO MATCH EXISTING
ROOF - FLAT ROOF TO REAR & SIDE EXTENSIONS
WINDOWS - NEW PVCu COLOUR BLACK
BI-FOLDING DOORS - NEW ALUMINIUM COLOUR BLACK
ROOF LANTERNS - PVCu COLOUR WHITE
RAINWATER GOODS - NEW PVCu COLOUR WHITE

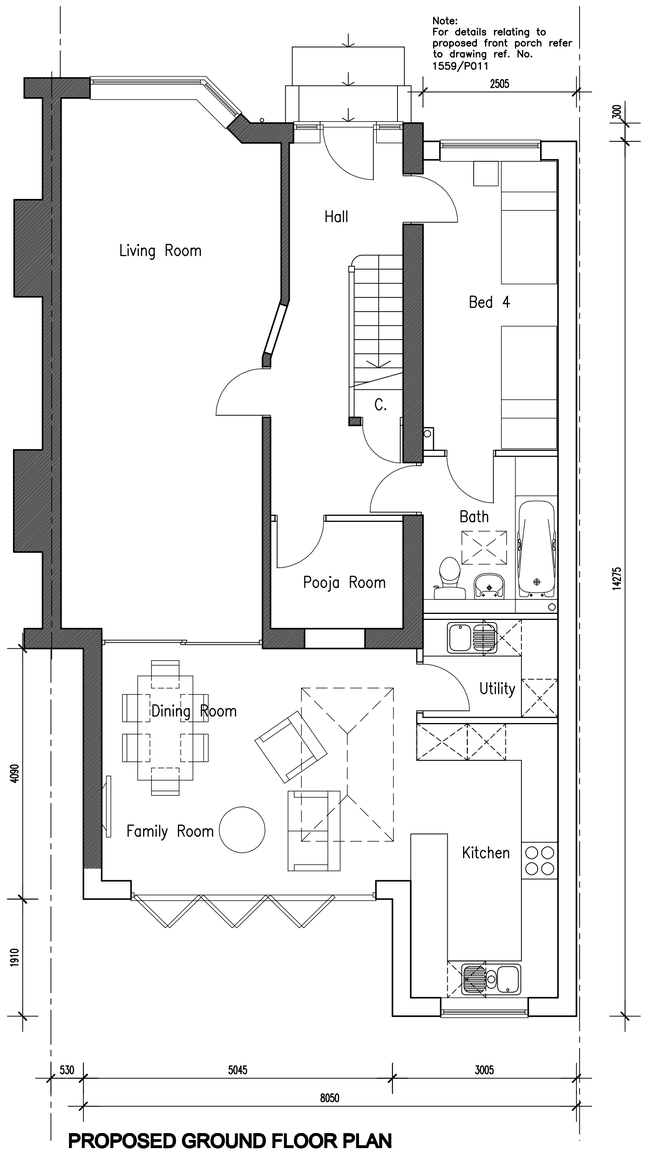

PROPOSED GROUND FLOOR PLAN
Scale 1:50

0m 5m 10m

Scale Bar – 1:50

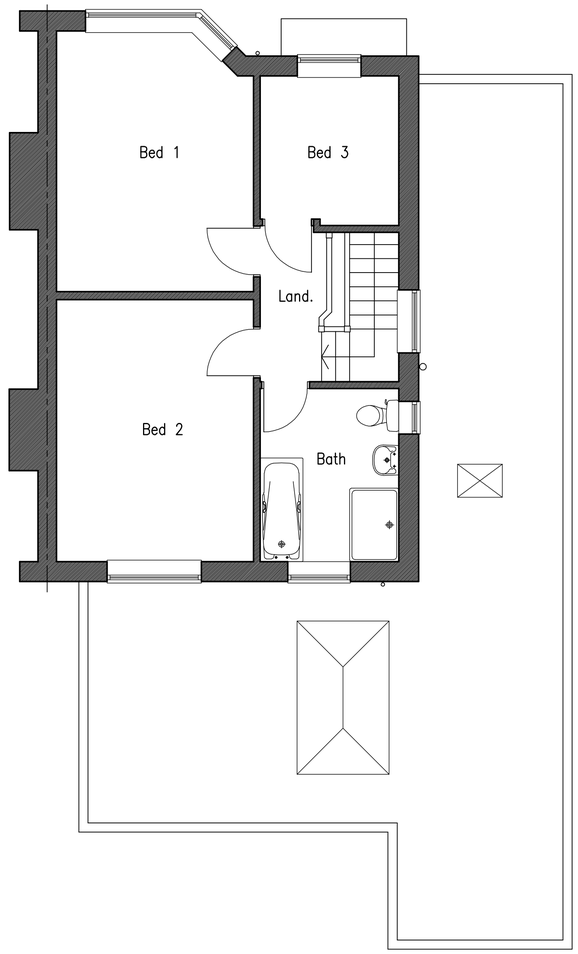

PROPOSED FIRST FLOOR PLAN

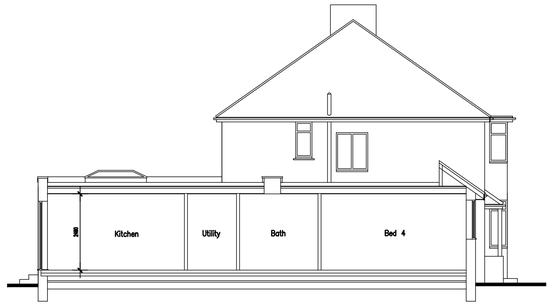

TYPICAL SECTION
Scale 1:100

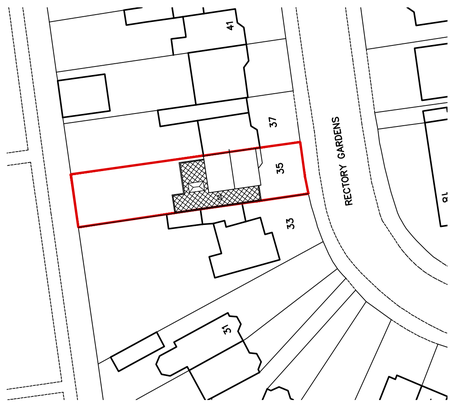

BLOCK PLAN
Scale 1:500

0m 10m 20m 30m 40m 50m

Scale Bar – 1:500

Information supplied based on Promap. All dimensions and distances subject to an accurate site survey being undertaken.

No dimensions to be scaled from drawing except for planning purposes.

The contractor should check all dimensions on site.

It is the contractors responsibility to ensure compliance with Building Regulations.

C.D.M. Regs. 2015. The Client is advised of his responsibilities to appoint a Planning Supervisor under these Regs. All works to comply with the C.D.M. Regs. 2015.

The Party Wall Act. 1996 The property owner is advised of the requirements of the Act, & the requirement to serve a Party Wall Notice on any adjoining owners as required under the act.

REVISIONS:

A. 21.10.22 Minor amendments.
B. 21.10.22 Minor amendments.
C. 09.12.22 Rear extension adjacent to No.37 reduced to 4.8m.
D. 12.12.22 Rear and side extensions reduced.
E. 12.07.23 Amendments to planning application ref. No. AWDM/1738/22 to reflect as built changes except front porch.
F. 21.09.23 Dummy pitch roof added to front side extension.

AMENDMENTS TO PLANNING APPLICATION REF.No. AWDM/1738/22

ADCS
Architectural Design
Computer Services

30 Foxley Lane
Worthing
West Sussex
BN13 3AD
Tel: 01903 260701
E-mail:
adcs@sky.com

Client
MR V. & MRS G. BALASUNDARAM

Project
PROPOSED SINGLE STOREY REAR & SIDE EXTENSIONS & ALTERATIONS 35 RECTORY GARDENS, WORTHING BN14 7TE

Drawing
PROPOSED FLOOR PLANS & ELEVATIONS

Scale	Date	Drawn
1:50 & 1:100 @ A1	18.10.22	TP

Drawing No. **1559/P02** Revision **F**