1 Vertical angled hit and miss fixed privacy Screen
2 Matching Balustrade
3 Extended steps
4 Lower Terrace width increased

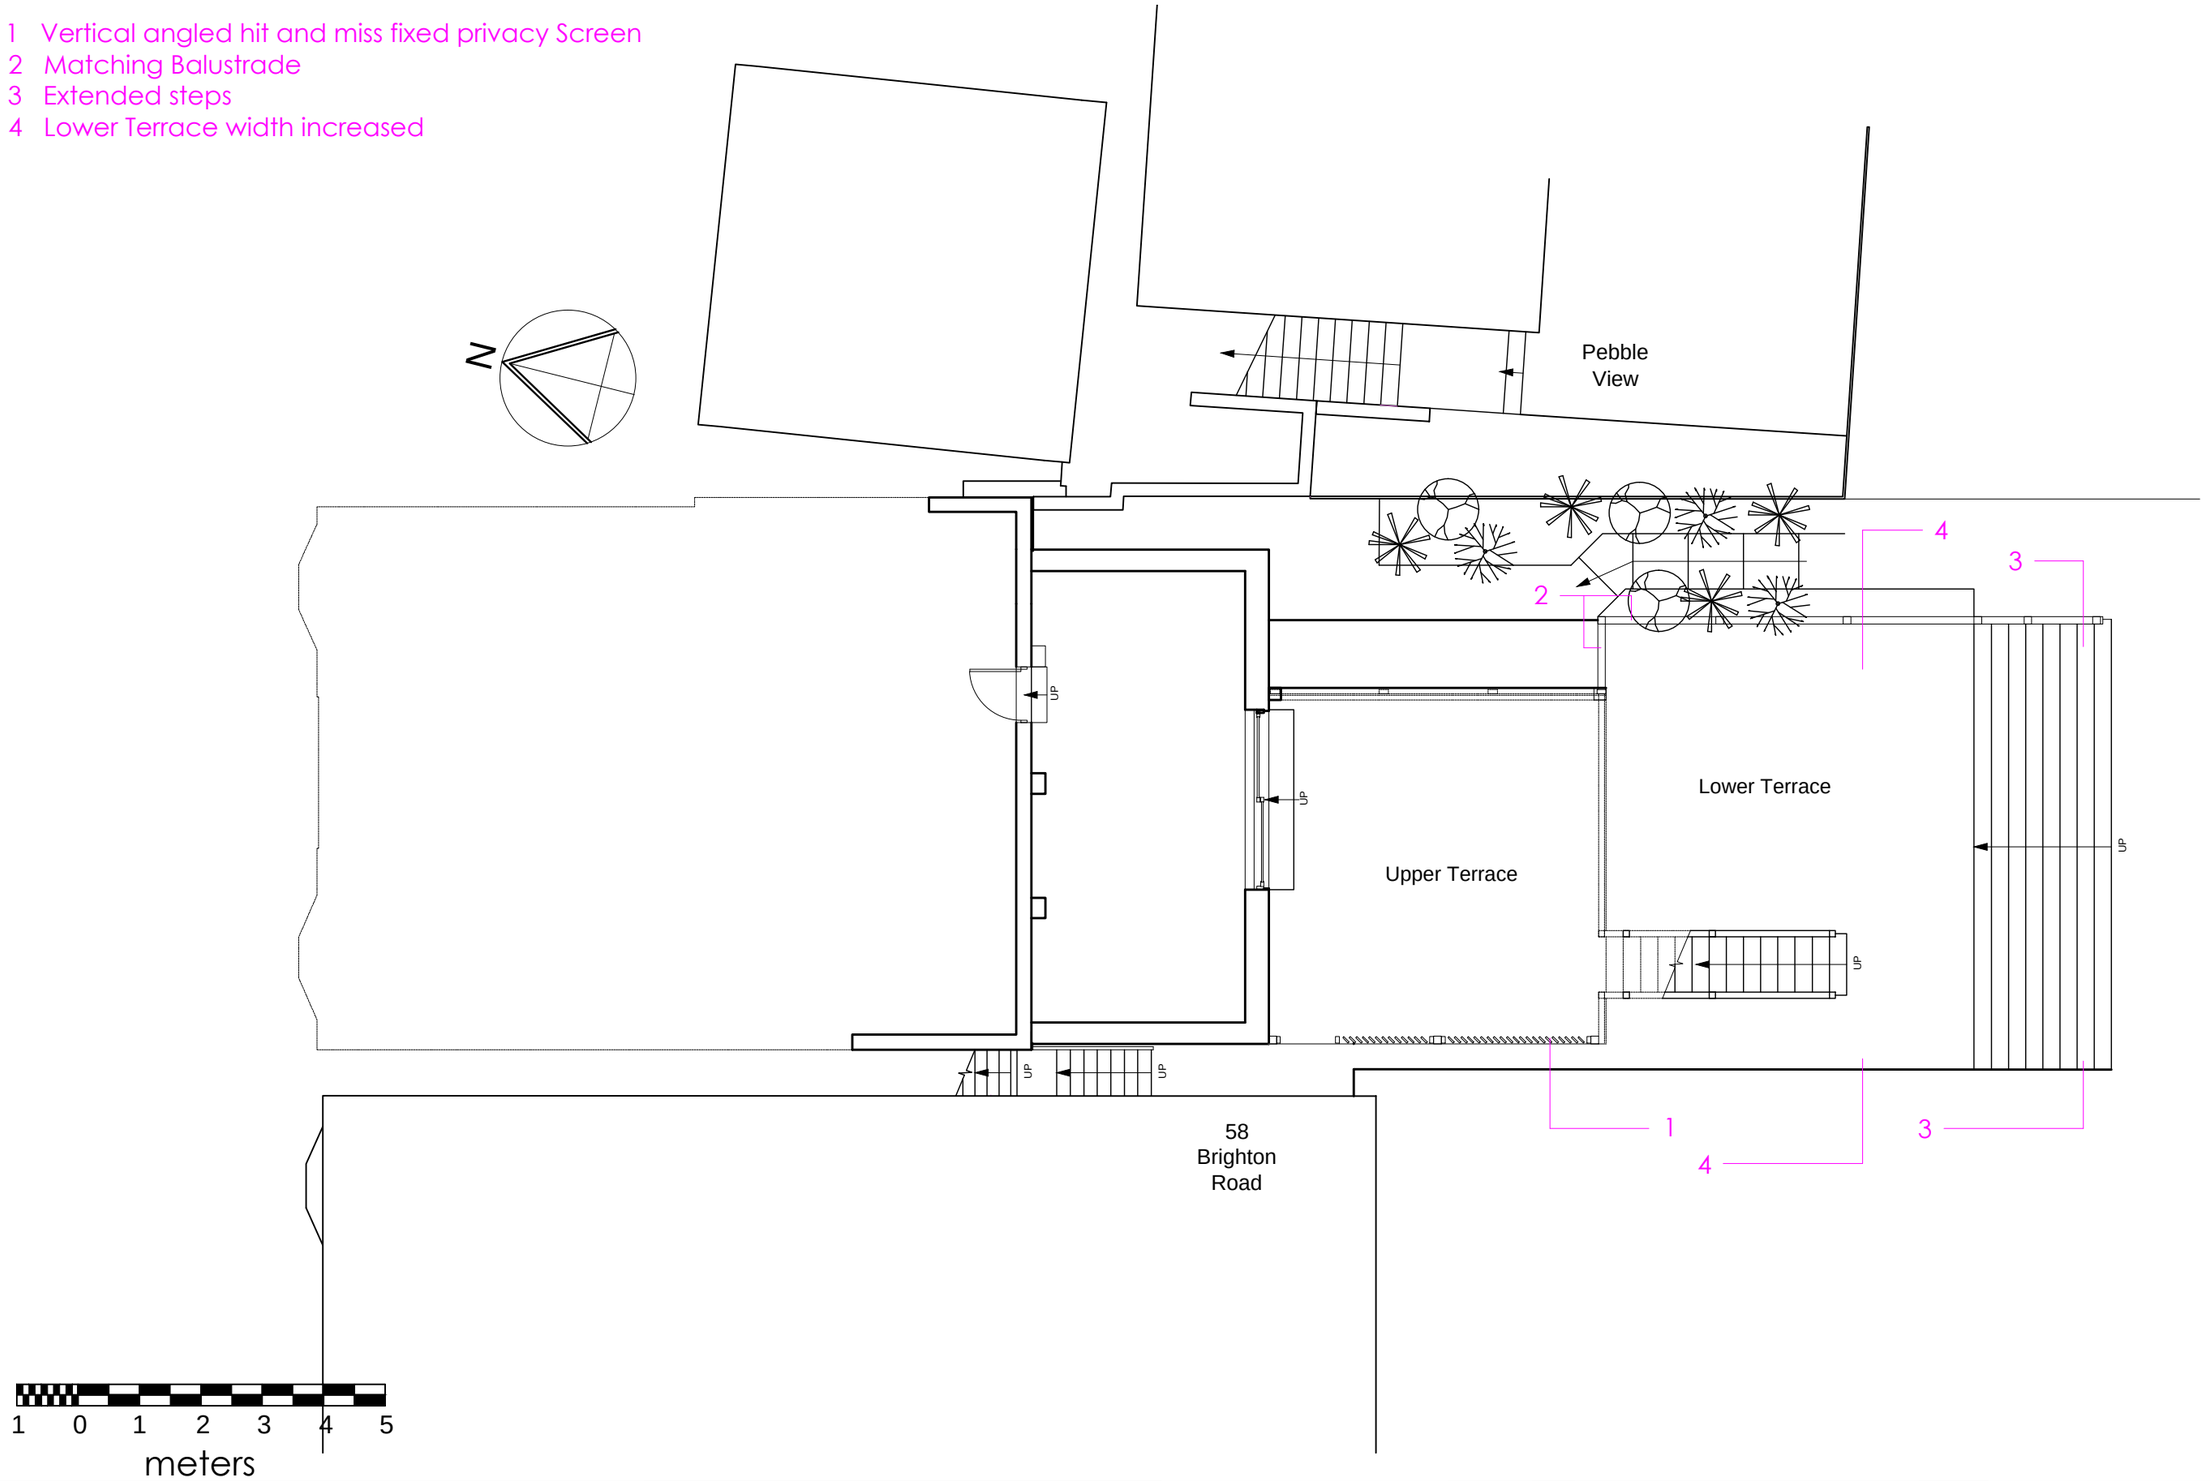

rev	date	by	description	chkd

drawing status
PLANNING SUBMISSION

Copyright of CPMG Architects Limited 2020. All rights reserved. No part of this publication may be reproduced, stored in any retrieval system or transmitted in any form or by any means without prior Permission of CPMG Architects Limited. Do not scale from drawing, use figured dimensions only. All dimensions to be checked on site.

ISO 9001: 2015 Quality Management
ISO 14001: 2015 Environmental Management
PAS 1192-2: 2013 Building Information Modelling

job title
60 Brighton Road Extension
Lancing

drawing title
As-built floor plan L00

CPMG Architects Ltd
People.Purpose.Place
Nottingham 23 Warser Gate, Nottingham, NG1 1NU 0115 958 9500
London 31 / 35 Kirby Street, London, EC1N 8TE 0207 492 1805
Birmingham The Lewis Building, Bull Street, Birmingham B4 6EQ 0121 481 2092
www.cpmg-architects.com enquiries@cpmg-architects.com

drawn by	date	checked by	scale
MC	21.12.2020	RF	1:100
job no.	drawing no.	revision	media
8251	20-033	P0	A3