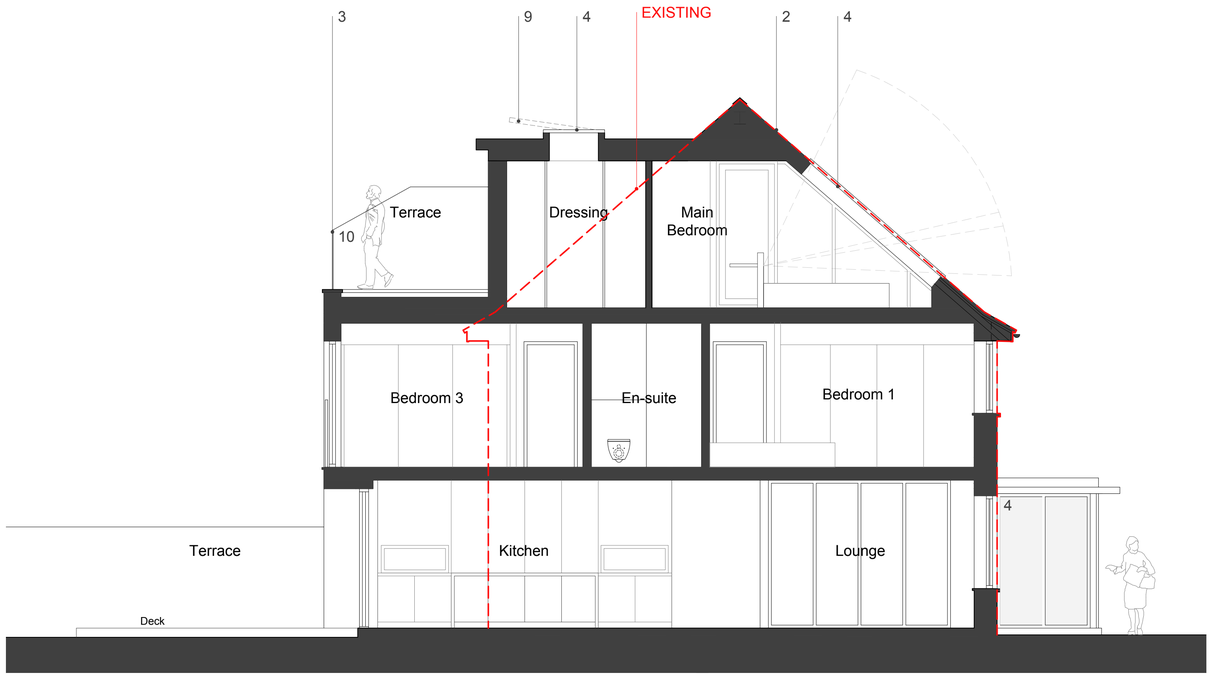

Section B-B 1:50

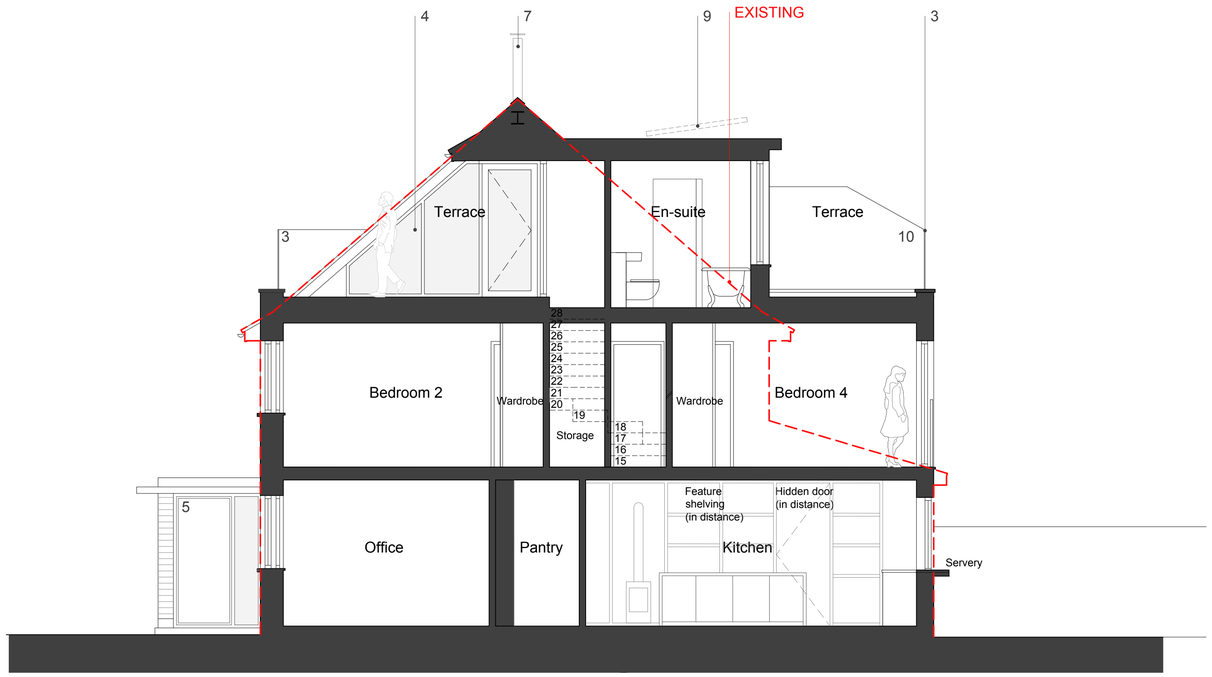

Section C-C 1:50

KEY

1A. Vertical timber cladding
1B. Horizontal timber cladding
2. Zinc cladding
3. Glass balustrade
4. Double glazed composite frame windows/doors/rooflights
5. Timber entrance door with a side light
6. Metal gutters,downpipes and fascias
7. Metal flue
8. White rendered walls
9. PV
10. 1.8 m high obscured glazed screen

amendments

rev.	date	comment	auth.	chkd.
-	29.09.21	Issued for planning	ACB	GI
A	26.10.21	Red line to show existing	ACB	GI

0 1 2 3 4 5 6 7 8 9 10
scale in metres 1:50

client
Mr and Mrs Roberts

drawing number
0642.PL.003

revision
A

project
62 Beach Green
Shoreham by Sea
BN43 5YA

drawing title
Proposed Sections
Planning

drawn by	checked by	riba work stage	date	scale/original sheet size
A.C.B	G.I	2	Sep '21	1:50 @ A1

www.abir.co.uk studio@abirarchitects.co.uk
Unit 1, Beta House, St John's Road, Hove, BN3 2FX, United Kingdom
Hove +44 (0)1273 724 384
Company No 06877117 VAT No 971 4147 17

© ABIR Architects Ltd. Check all dimensions on site before work is undertaken. All goods, materials and workmanship to conform with current building regulations, BSS and COP's.

ABIR architects

RIBA Chartered Practice