


Proposed Drive entrance gate 1:50




Proposed Rear Elevation 1:50

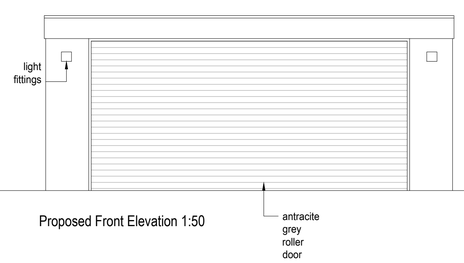

Proposed Front Elevation 1:50



Proposed Typical Side Elevation 1:50

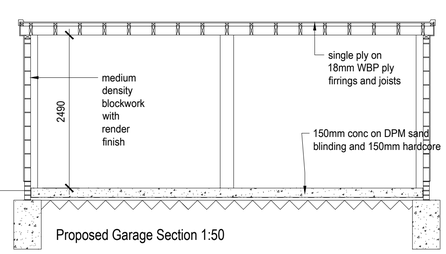

Proposed Garage Section 1:50

Rev C 07.08.20 AS BUILT amendments

bpm Architectural Services Limited

client: 111a Arundel Road Development LLP

project: Land South of 14 Ring road
Norbury Drive
Lancing
West Sussex

project ref: 1515 Drawing No. BR04C

drawing title: Garage plans and elevations

drawn by: J Boys

date: Jan 17 scale: NTS@ A1

www.bpmnet.co.uk
info@bpmnet.co.uk

Do not scale off drawing, check all dimensions on site before all work is commenced

All goods materials workmanship to conform with current building regs BSS and COP's