

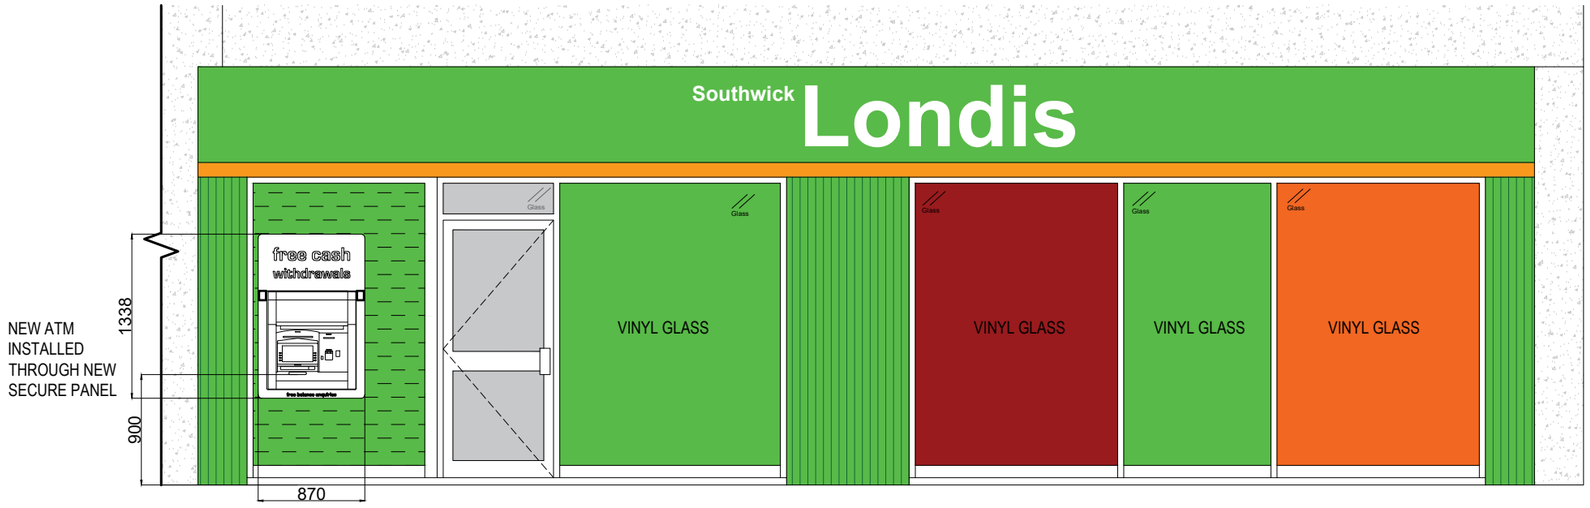


AS-INSTALLED FRONT ELEVATION

Scale 1:50

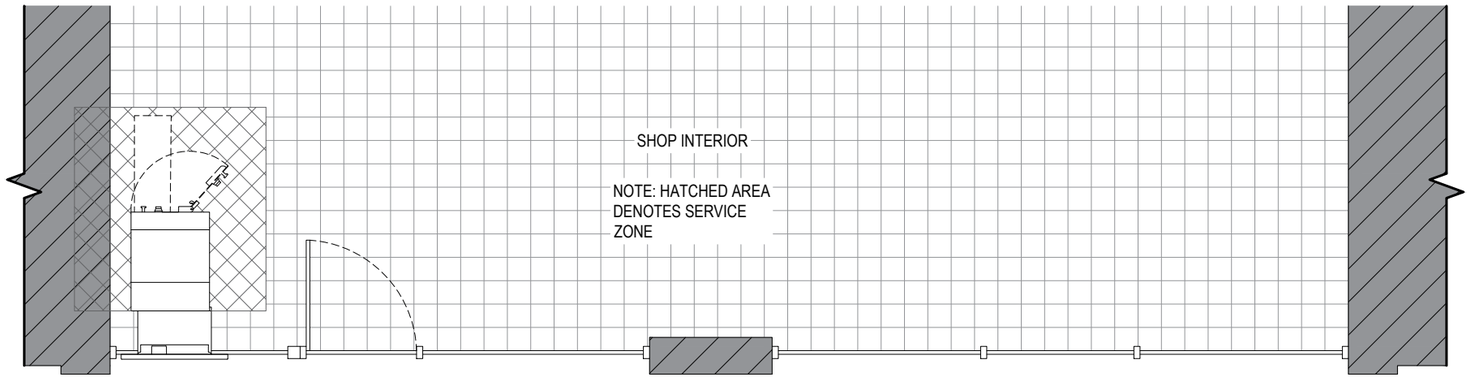

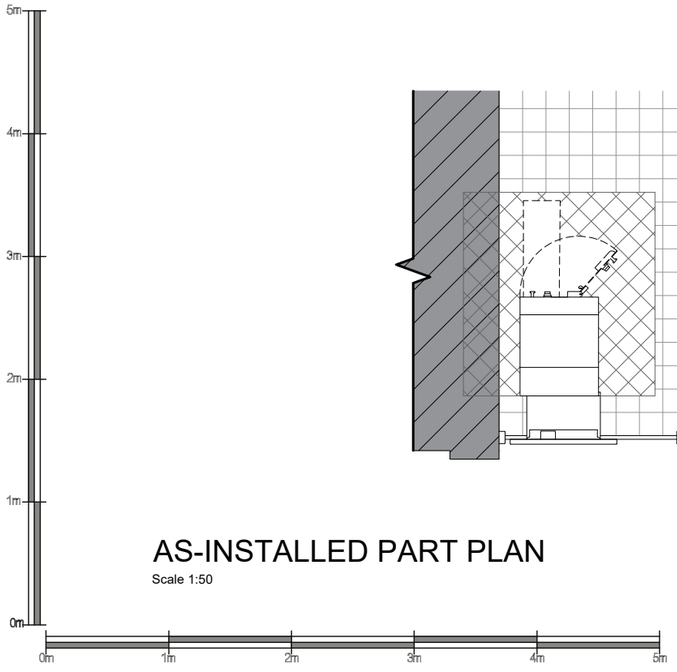

AS-INSTALLED PART PLAN

Scale 1:50

NM GROUP

Date:	Comments:	By:

GENERAL NOTES:

1) All dimensions in millimeters unless otherwise stated.

Site:
Windmill Convenience,
3-4 Windmill Parade,
Southwick,
Brighton

Drawing Title:
As-Installed Plan and Elevation

Ref:	Date:	Rev:
3473629_AI	12/06/2019	
Scale: 1:50	Paper: A3	Date Rev: