
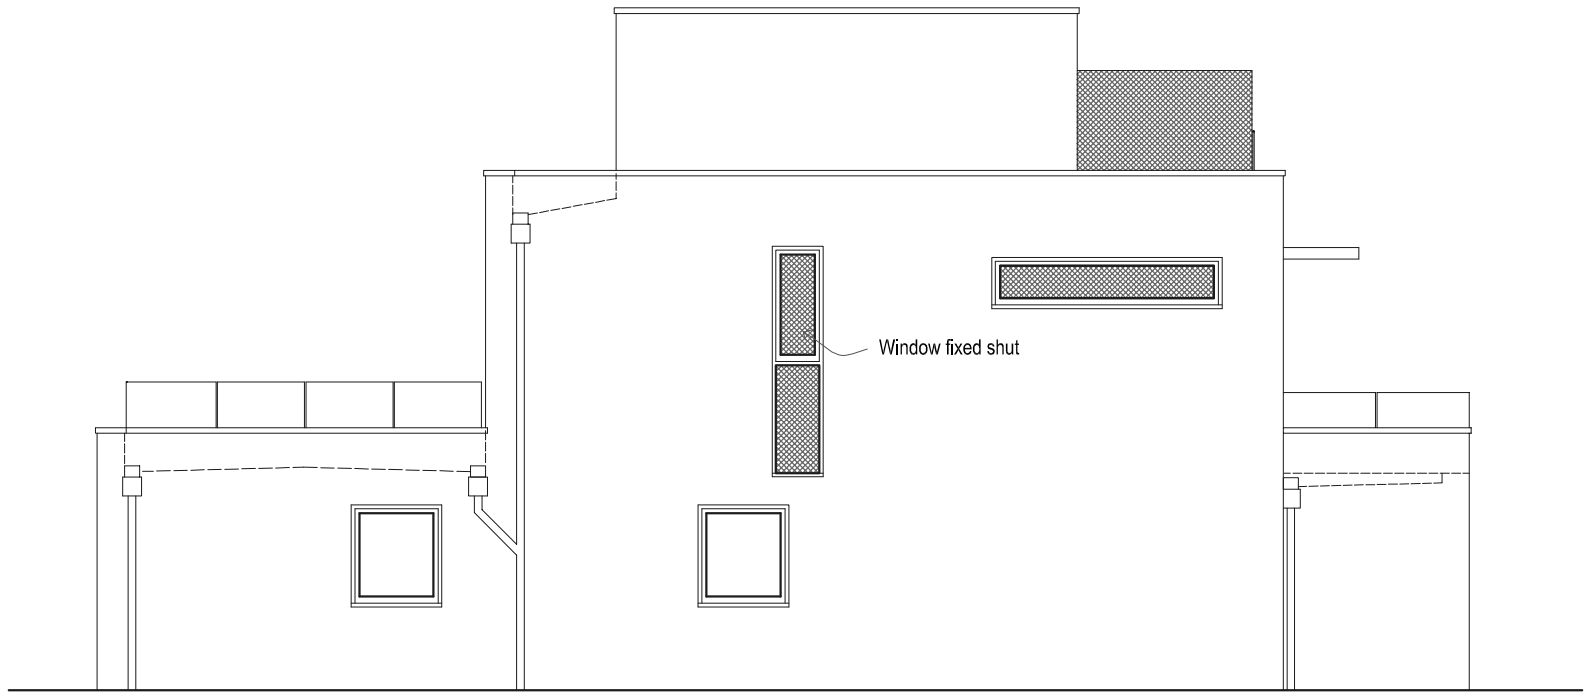


Side Elevation (West) @ 1:50

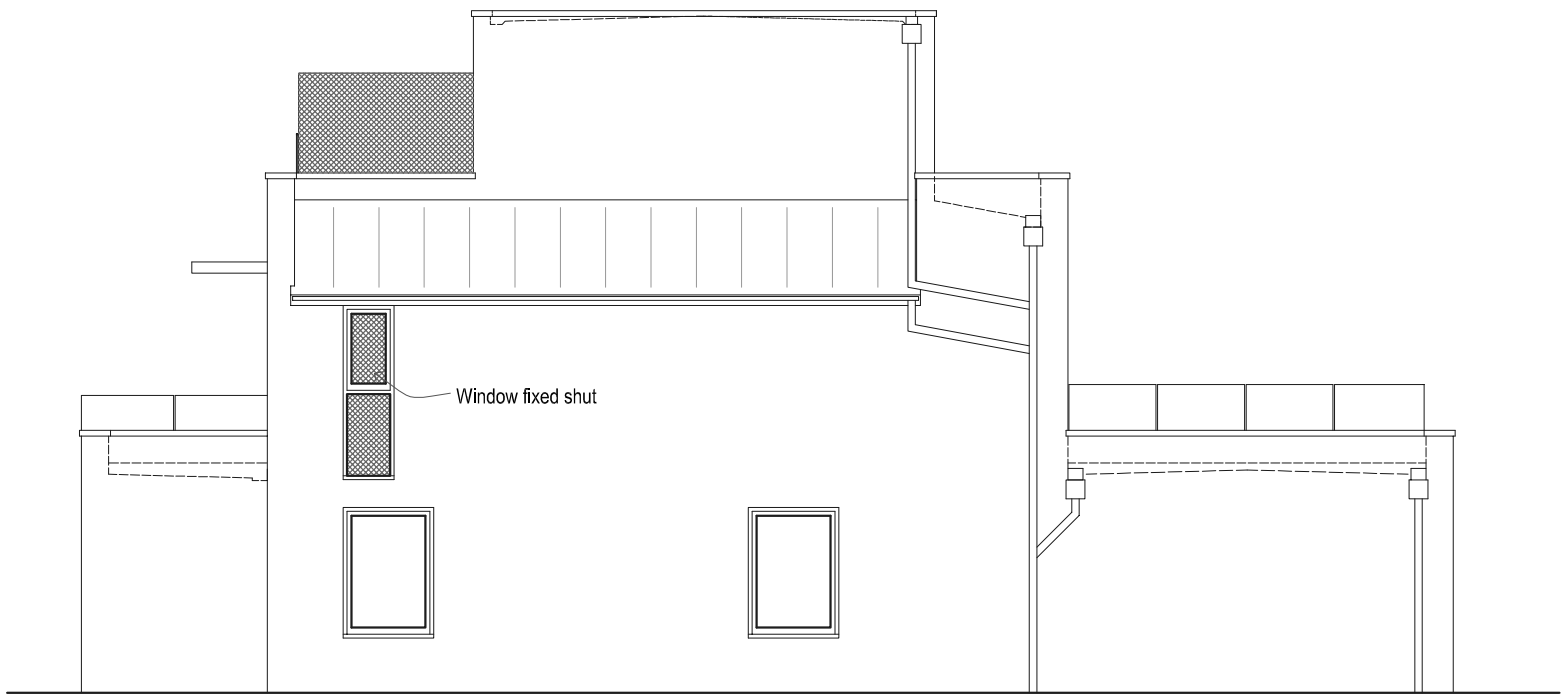

Side Elevation (East) @ 1:50

Rev	Description	Date
A	Window fixed shut note added	24.05.13

Job Reference
Replacement House
144 Old Fort Road
Shoreham-By-Sea

Client
Linkspan Interiors

Drawing Title
Side Elevations
as built

Drawing No
ADC475/10

Rev
A

Date	Scale	Dwg Size	Plot Style	Drawn	Checked
14.03.13	1:100	A3	ADCgreyscale	AD	AD

All dimensions to be checked on site and do not scale from this drawing. This drawing should be approved by Local Authority Building Control or other appropriate checking authority prior to commencement of work. This drawing should not be reproduced without the prior consent of the author

Alistair Dodd Consulting Ltd
Architectural Services
Construction Drawing Packages
CAD Draughting

72a Beaconsfield Road . Brighton . East Sussex . BN1 6DD
Tel: 01273 669466 . Fax: 01273 669467
Email: info@adcbrighton.co.uk