
AMENDMENT

Ordnance Survey
Licensed Partner

ADUR & WORTHING
PLANNING SERVICES

PLAN	AWDM/ 0987/14
DATE VALID	5/8/14.

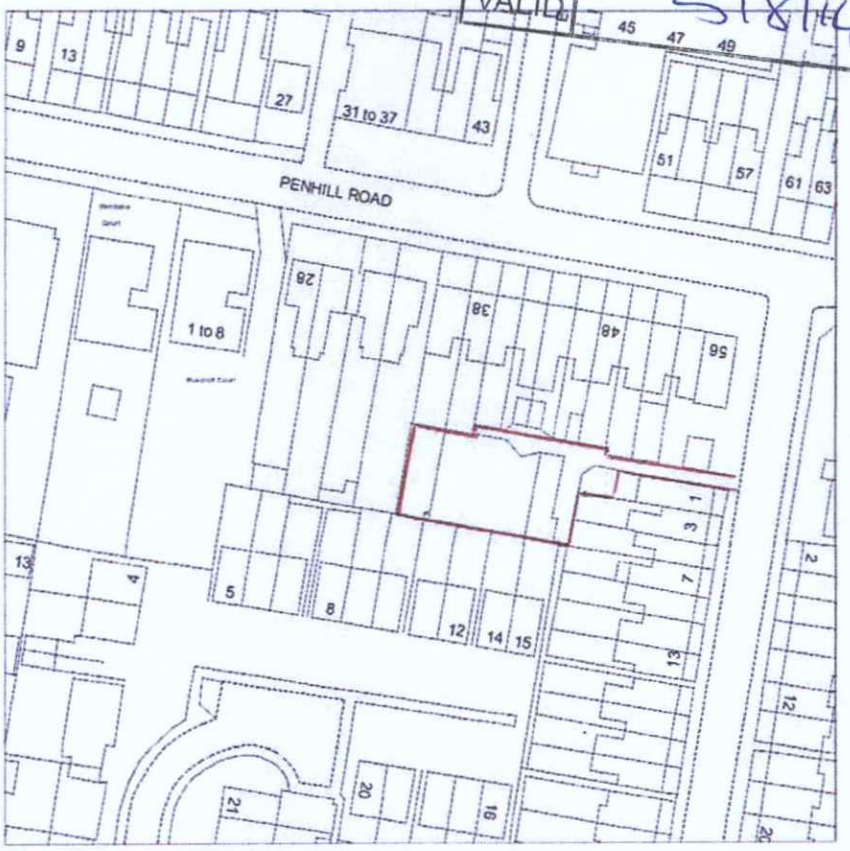

Reproduction in whole or in part is prohibited without the prior permission of Ordnance Survey.

Ordnance Survey and the OS Symbol are registered trademarks and OS MasterMap® is a trademark of Ordnance Survey, the national mapping agency of Great Britain.

The representation of a road, track or path is no evidence of a right of way.

The representation of features as lines is no evidence of a property boundary.

Scale 1:1250

0 25 50

Metres

Supplied by: Getmapping
OS License Number: 100030848

A4

5/8/14 - Revised red line