From: Norman <contact@normanray.co.uk>
Sent: 22 May 2009 11:44
To: Peter Barnett
Subject: Fw: 28, The Meadway, Shoreham-by-sea
Attachments: 2904 1 Site Set up.pdf

With apologies,

Ref: vertical tile hanging although the tiles are a brown brindle the correct name is:

REDLAND Plain concrete tile 52 Breckland Brown

Have a good weekend,

Norman
----- Original Message -----
From: Norman
To: Peter Barnett
Sent: Friday, May 22, 2009 11:15 AM
Subject: 28, The Meadway, Shoreham-by-sea

Dear Mr.Barnett,

Following our meeting earlier this morning when you approved the Redland Plain Concrete Brown Brindle tile as a substitute for the tile previously submitted to you together with the Redland 50 Antique Red roof tiles & Ibstock New Cavendish bricks I enclose details of the proposed on site Parking & Materials Storage as required under Condition 3 of the approval.

The area at the front of our new home at no 28 is restricted (12.7m wide x 6.0m deep) and particularly during the initial stages of construction (disposal of shingle, sheet mesh, concreting, bricks & blocks etc.) most of this area will be needed for access and storage of bulk materials. Therefore initially. the contractors are to be permitted to park on the large vehicular hardstand to the front of our house at no 30.

When this initial "groundworks" phase is completed there will be space for on site for parking of two vehicles (builders vans) and a small compound for materials all as shown on the enclosed marked up drawing no 2904/1. The hardstand in front of no 30 will be used as the "overflow" carpark for builders vehicles and when required our garage will be used for secure storage of fittings etc. No kerbside parking of contractor's vehicles will be allowed.


With reference to the width of the solar panel I would confirm that this will be limited to between the ridge tiles either side of the false pitched roof to the front dormer.

The privacy screens to either side of the Roof Garden will comprise a stainless steel frame glazed in obscured safety glass up to a height of 1.7m measured from the finished paving to the Roof Garden. This is shown on drawing no. 2904/5 Elevations and 2906/6 Section. Nearer to the time that these are to be incorporated within the structure I shall prepare some working drawings in conjunction with the fabricating company & would be pleased to forward for your approval, these shall however fully comply with the approved design.

I would be most grateful to receive your approval to discharge the aforementioned conditions.

Thank you for your assistance & advice in this matter.

Yours sincerely,

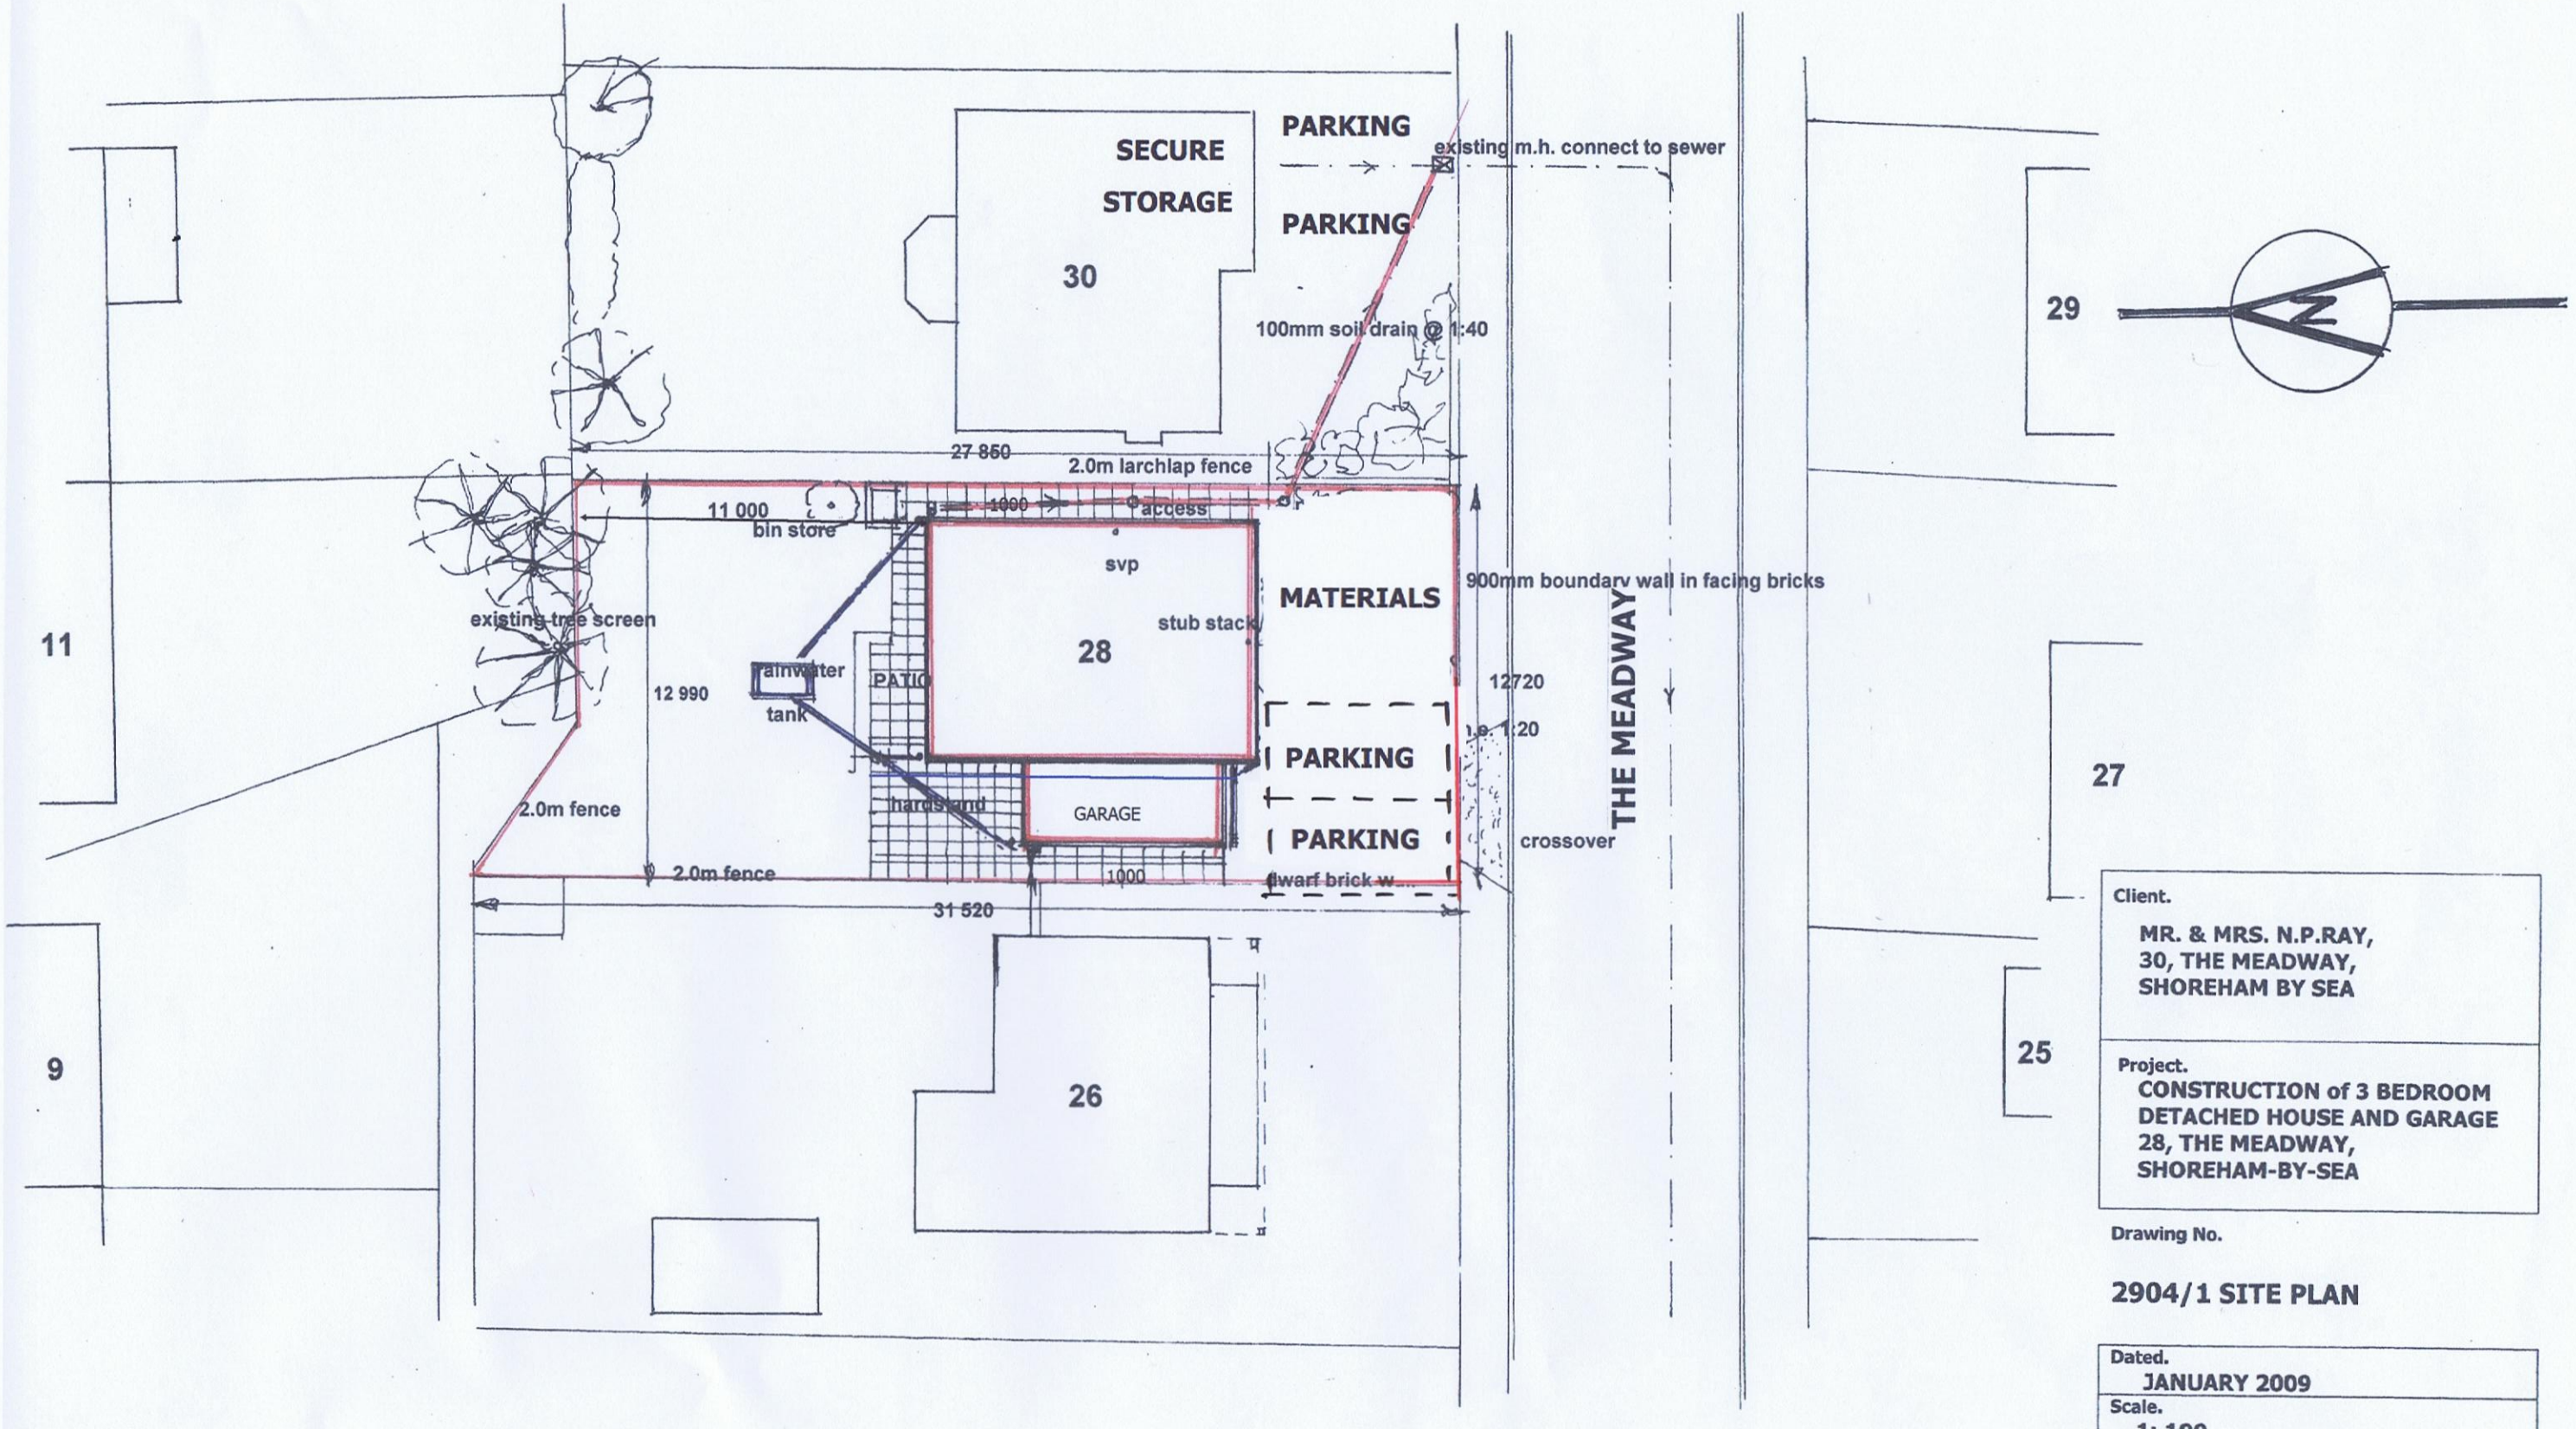

SCALE IIIIIIII I I I I I I I I
A3@
1:200 0 1 2 3 4 5 6 7 8 9 10

Client.
MR. & MRS. N.P.RAY,
30, THE MEADWAY,
SHOREHAM BY SEA

Project.
CONSTRUCTION of 3 BEDROOM
DETACHED HOUSE AND GARAGE
28, THE MEADWAY,
SHOREHAM-BY-SEA

Drawing No.

2904/1 SITE PLAN

Dated.
JANUARY 2009

Scale.
1: 100

Norman Ray Associates Ltd.
Architectural and Interior Design
Sussex House,
30, The Meadway,
Shoreham-by-sea,
BN43 5RP

Tel & Fax: 01273 455875
e- contact@normanray.co.uk