T.P. OFFICE COPY

project	REAR EXTENSION TO 120 STATION ROAD WORTHING BN11 1JY
client	Mr & Mrs A Buckley 120 Station Road Worthing BN11 1JY 01903 202 741
architect	Peter Wilson Hilary Mount Way Lancing Sussex BN15 0QD 01903 755765
drawing	scale 1:100 date: 29/08/2007 revision date

plan & elevation

tp632/10

BOROUGH OF WORTHING
DEPOSITED
TP. REF. No.
WB/ 07/1093/FUL
31/8/07

Upvc windows and French doors
Window cill to match existing
White painted rendered wall to match existing
Velux roof light in existing roof
Tiles to match existing with gutter varying in width

EXTENSION



South elevation

Station road

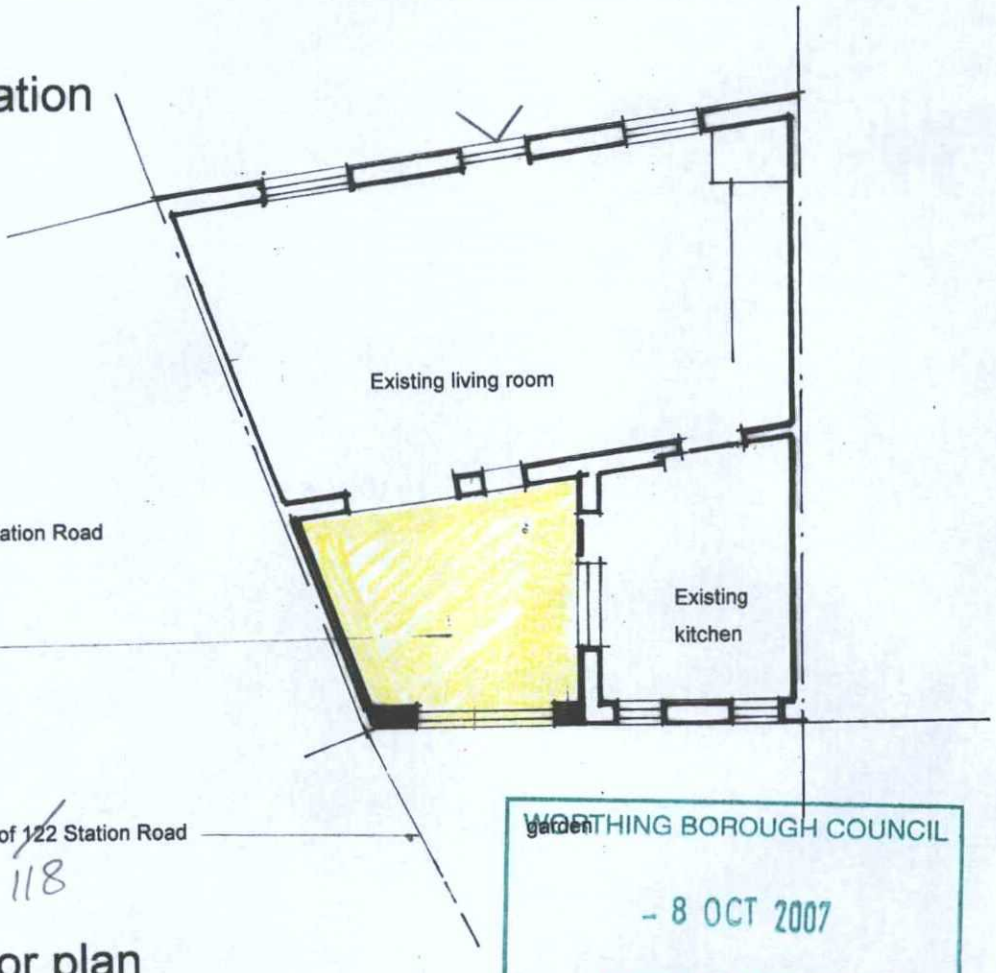

118
2 storey house of ~~122~~ Station Road

New DINING ROOM

Single storey extension of ~~122~~ 118 Station Road

Ground floor plan

WORTHING BOROUGH COUNCIL
- 8 OCT 2007
CONSENT GRANTED
SUBJECT TO CONDITIONS