
REV.	AMENDMENT	BY	DATE
a	lighting column dimensions added	sab	05.06.18
b	lighting highlighted	sab	11.06.18
C	Parking, bin store and street lighting amended to reflect as built.	hb	24.07.18
D	Lighting baffle note added and height to extg column reduced	hb	24.07.18

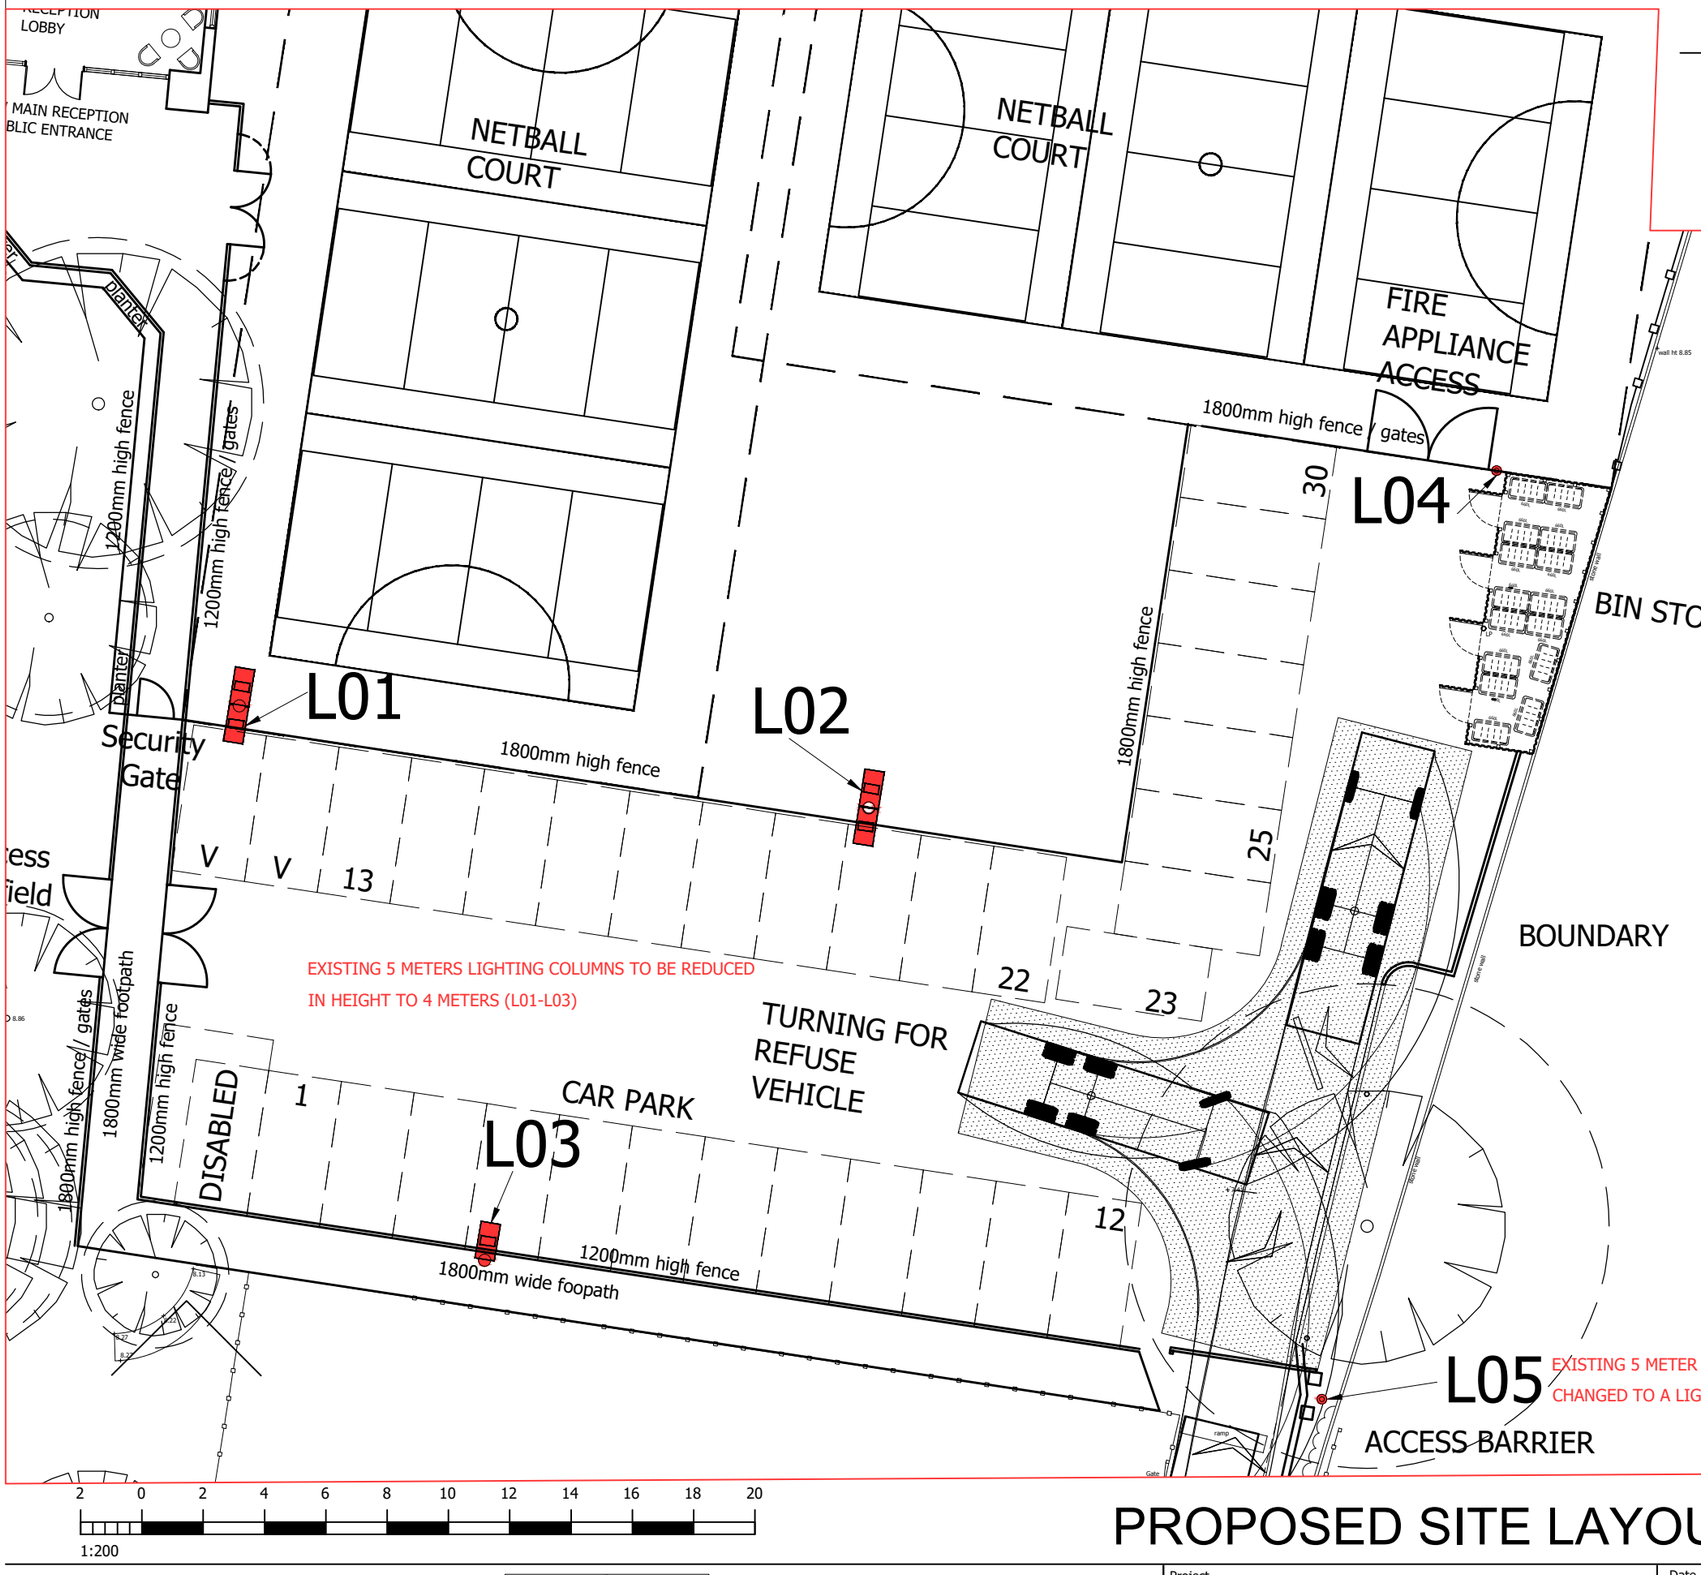

KEY:

L## STREET LIGHTING LANTERNS
ALL LIGHTING COLUMNS TO INCORPORATE A BAFFLE ON THE EAST SIDE

L## LIGHTING BOLLARDS

N
W E
S

PROPOSED SITE LAYOUT

RIBA Chartered Practice

ISO 9001 Registered Firm Certificate No. GB2002767
International Accreditation Board Registration No. 0044/1

UNIT 2, MARTINS BARN, BIRDHAM ROAD
CHICHESTER, WEST SUSSEX, PO20 7BX
TEL: 01243 514131 FAX: 01243 511488
office@the-seaman-partnership.co.uk
w.w.w.the-seaman-partnership.co.uk

Project	GLEBE PRIMARY SCHOOL CHURCH LANE SOUTHWICK	Date 25.08.17	Drawn by AA
		Scales 1:200	Status Planning
Drawing	SITE PLAN	Job No TSP542/00/A/1001	Dwg No Revision D

the SEAMAN PARTNERSHIP Ltd