1m 2m

1:20 Scale Bar

Refer to drawing /06 (north elevation)

ADUR & WORTHING PLANNING SERVICES	
PLAN	AWDM/ 0950/17
DATE VALID	21 JUN 2017

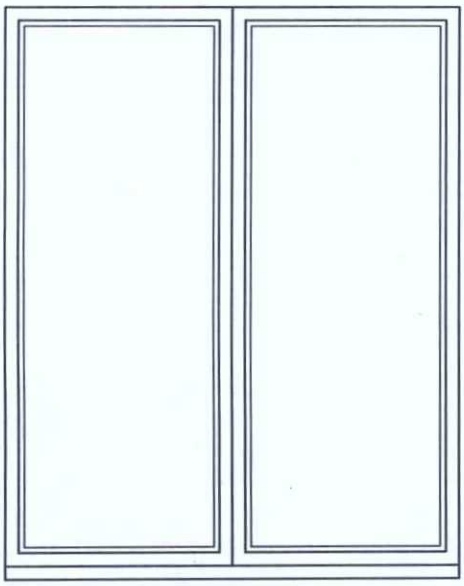

White PVCu DG casement window

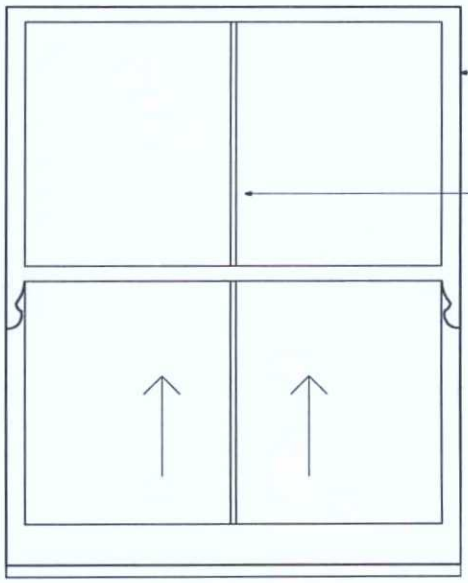

SOUTH

~~North~~ Elevation (Existing)

External view

SOUTH

~~North~~ Elevation (Proposed)

External view

(See Agents letter dated 26.09.17)

Project	Shoreham Dental Centre, 29 East Street, Shoreham-by-Sea	Drawing Title	Treatment 4 Replacement Window
Copyright of: Sussex Architectural Services Wicket View, Cuckfield Lane Warninglid, West Sussex Telephone: (01444) 461355 e: info@sussexarchitecturalservices.co.uk w: www.sussexarchitecturalservices.co.uk		Scale 1:20 @ A4 Date June 2017 Drawn -	Drawing Number 16-117.1 11