General Notes

This drawing is to be read in conjunction with all relevant specifications and drawings issued.
The contractor is to check and verify all building and site dimensions and check levels before work commences
For discrepencies or ommissions contact RAA
Do not scale this drawing, check all dimensions on site
All work and materials to be in accordance with current applicable statutory legislation and to comply with all relevant Codes of Practice and British Standards.

© Rashad Al-Karooni Architecture - RA ARC Ltd.



ELEVATION - NORTH, EXISTING

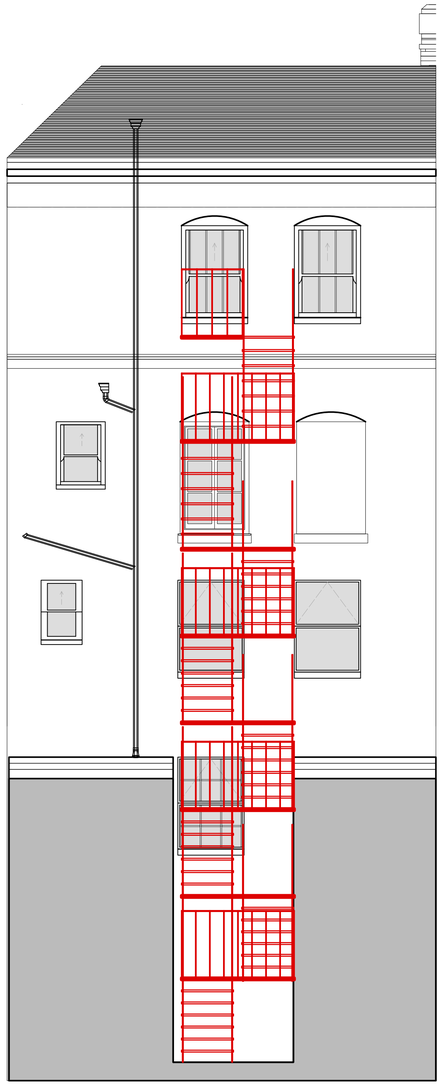

ELEVATION - SOUTH, EXISTING

RED LINE DENOTES EXISTING STAIRCASE, TO BE REMOVED

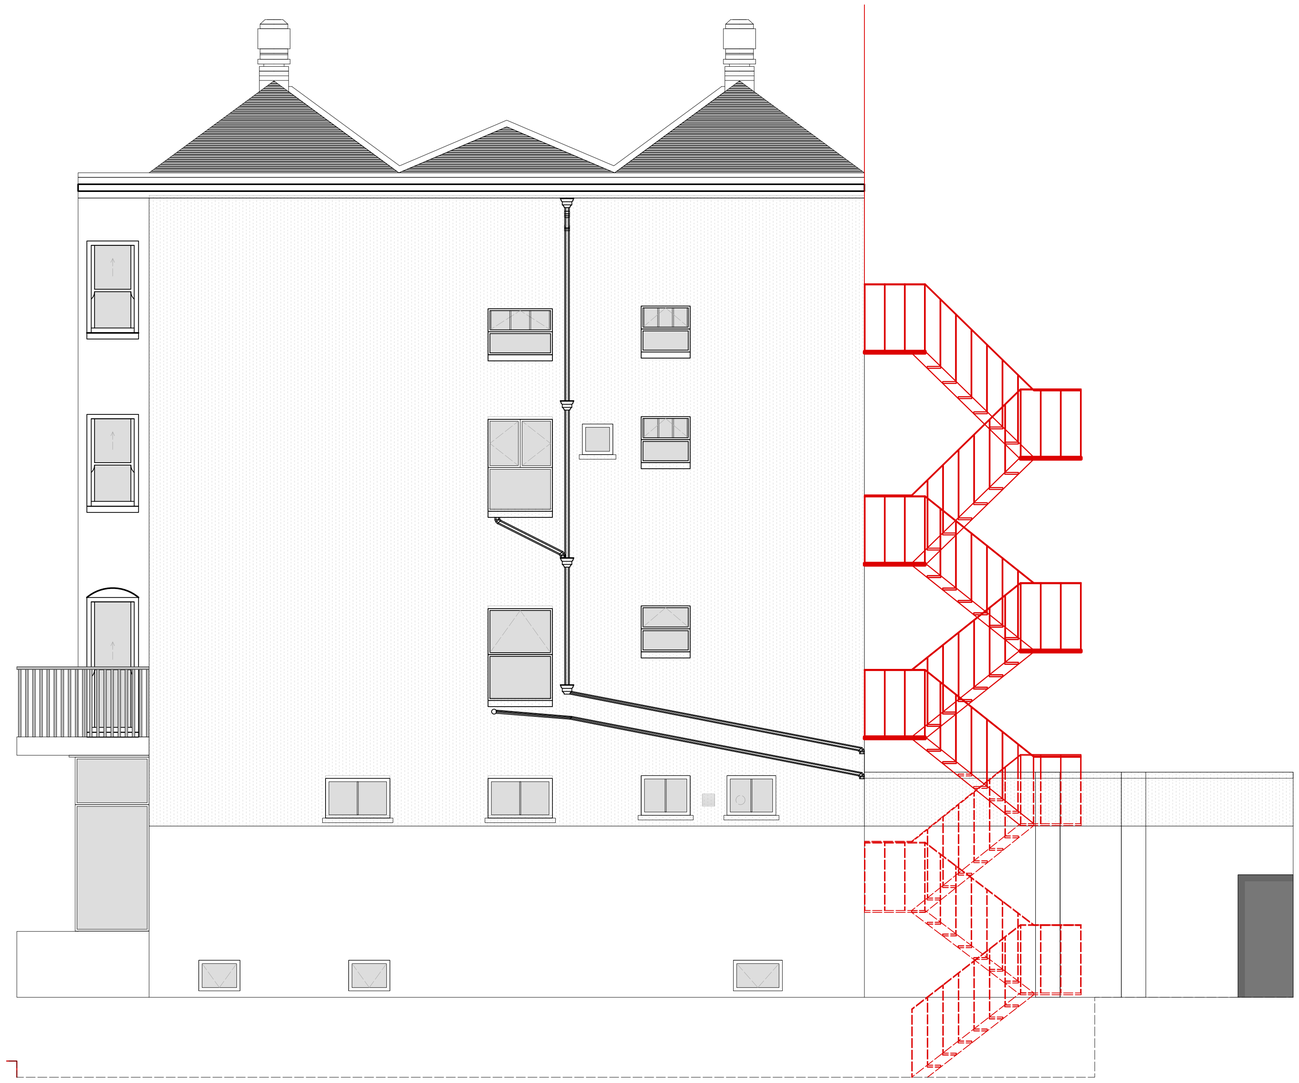

ELEVATION - EAST, EXISTING

R A A

RASHAD AL-KAROONI ARCHITECTURE

RAA, Wells Terrace, Finsbury Park,
London N4 3JU
www.ra-arc.co.uk
rashad@ra-arc.co.uk
+44 7546 178 620

PROJECT ADDRESS:

70 Marine Parade,
Worthing,
BN11 3QB

NOTES

Drawing not for construction, design intent only
Do not scale from this drawing, except for planning purposes
Check all dimensions on site
Subject to survey
Subject to site inspection
Site boundary lines are indicative only
Subject to Structural Engineer approval
Subject to Building Control approval

PROJECT STAGE: EXISTING

REV	DATE	BY	REVISIONS
-		RA	-
A		RA	STAIRCASE SHOWN ON DRAWING

DRAWING: **ELEVATIONS - EXISTING**

Scale: 1:50 **A1** **Date: 20.01.24**
Drawn: RA
Drawing No: **RAA-150-ELE-EXST** **Rev:** A