Copyright (c) 2023

REVISION

NOTE:
The contractor is to check all site dimensions and levels before work starts. Report any discrepancies.

This drawing must be read with and checked against all structural and other specialist drawings, specifications and bills of quantities. Report any discrepancies.

The contractor is to comply with all current British Standards and Building Regulations whether or not specifically stated on these drawings.

Materials:

1st floor enlargement

Roof:
Felt flat roof,
tiled pitched roof ~~to match existing~~

Walls:
Tile hung, ~~to match existing~~

Fascia and soffit:
To match existing

Windows:
To match existing

Hip to Gable

Roof:
Tiled pitched roof ~~to match existing~~

Walls:
Tile hung, ~~to match existing~~

Fascia and soffit:
To match existing


Dormer

Roof:
Felt flat roof,
tiled pitched roof ~~to match existing~~


Walls:
Tile hung, ~~to match existing~~

Fascia and soffit:
To match existing

Windows: To match existing

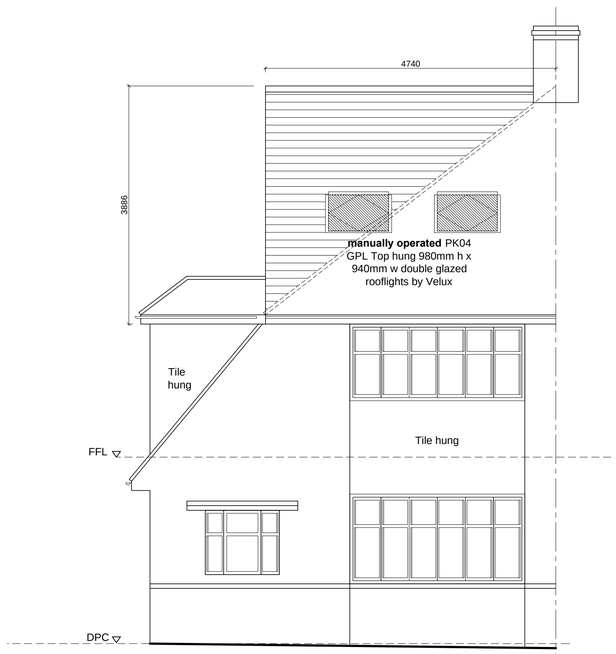


Front (N) Elevation 1:50

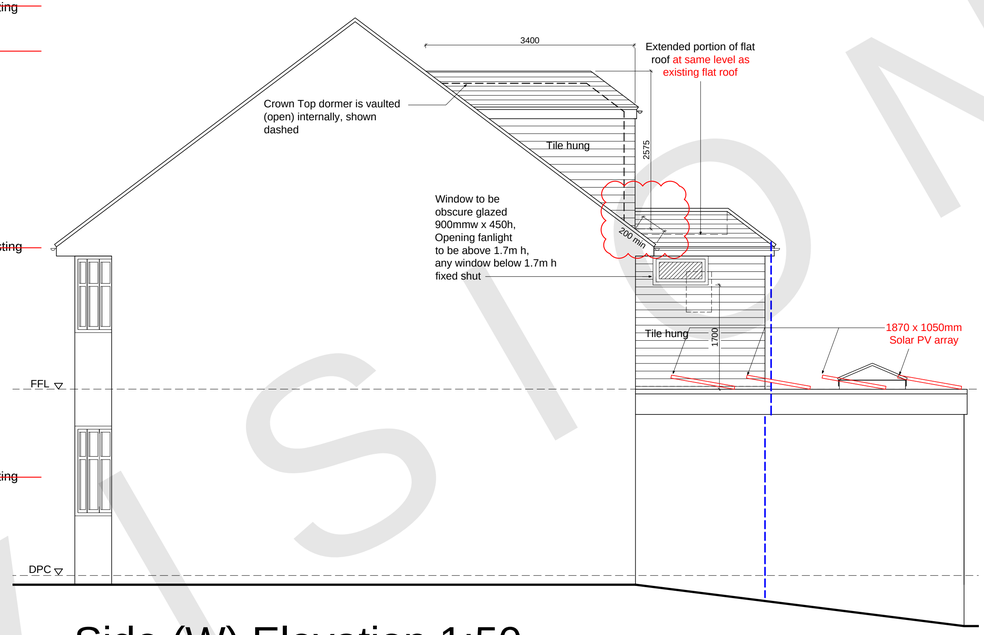


Side (W) Elevation 1:50

(ABOUT PARTY WALL)
OUTLINE OF ORIGINAL DWELLING OUTLINED BLUE

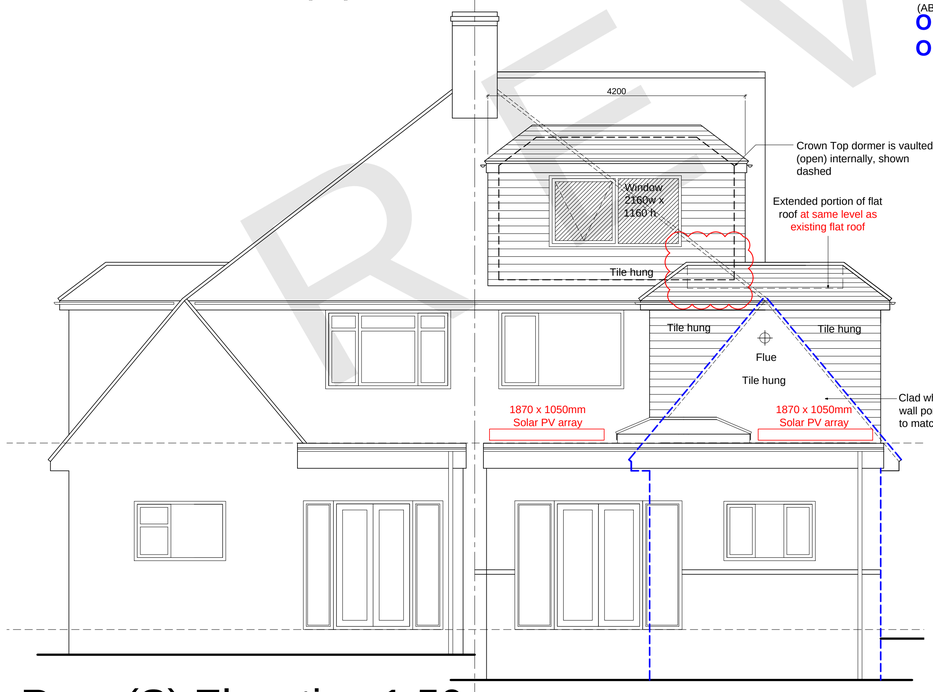

Rear (S) Elevation 1:50

OUTLINE OF ORIGINAL DWELLING OUTLINED BLUE

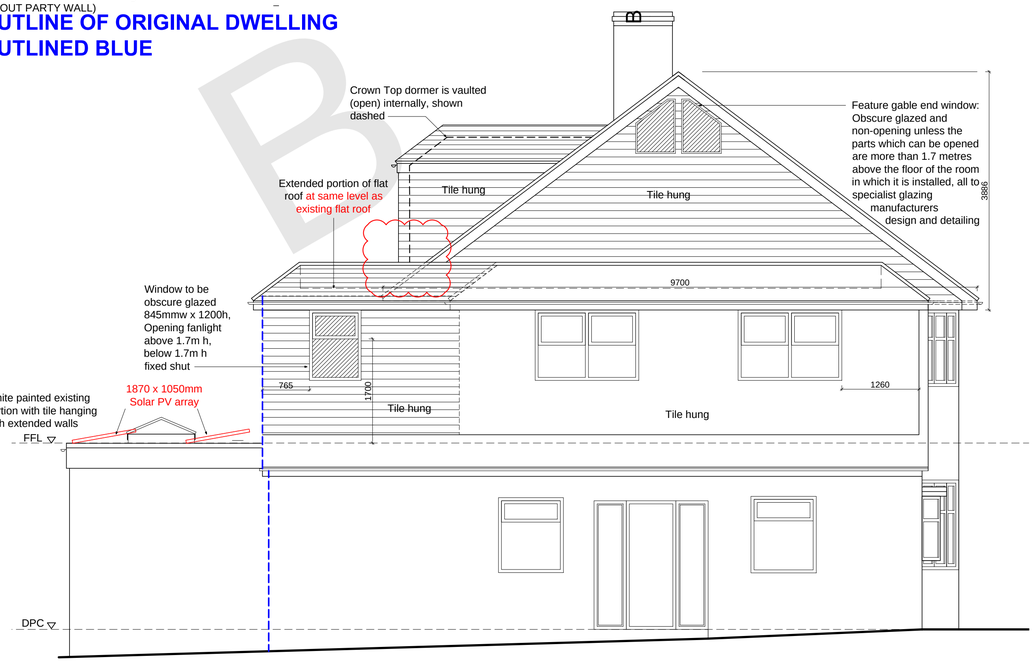

Side (E) Elevation 1:50

OUTLINE OF ORIGINAL DWELLING OUTLINED BLUE

Existing tiles: All existing pitched roof tiles and all existing wall-hung tiles to be replaced with concrete plain tile or 'Envirotile', ~~colour to match existing.~~ Tile hung bay tiles to remain unchanged or to be replaced with concrete plain tile or 'Envirotile'.

Proposed tiles: All proposed pitched roof tiles and wall-hung tiles to be concrete plain tile or 'Envirotile', ~~colour to match existing.~~

S73 AMENDMENTS SOUGHT HIGHLIGHTED IN RED

1m 2m 3m 4m 5m
1:100 Scale Bar

1m 2m 3m 4m 5m
1:50 Scale Bar

FOR PLANNING

Rev.	Date	Description	By
-	-	-	

Client
Ms Leake Date

Project
Alterations To:
1 Mill Avenue
Shoreham-by-Sea

Drawing Title
Elevations
as Proposed

Copyright (c) 2023 of:
Sussex Architectural Services
Wicket View
Cuckfield Lane
Warninglid
West Sussex
Tel:(01444) 461720
Email: info@sussexarchitecturalservices.co.uk

Scale 1:100, 1:50 @ A1
Date June 2023
Drawn -
Drawing Number **19-161.4 04 rev.B**