Copyright (c) 2019

AMENDMENT

NOTE:
The contractor is to check all site dimensions and levels before work starts. Report any discrepancies.


This drawing must be read with and checked against all structural and other specialist drawings, specifications and bills of quantities. Report any discrepancies.

The contractor is to comply with all current British Standards and Building Regulations whether or not specifically stated on these drawings.

ADUR & WORTHING PLANNING SERVICES
PLAN AWDM/1221/19
DC Rec'd 9/9/19



Front Elevation 1:~~100~~ 50
(see Agents letter dated 01.10.19)

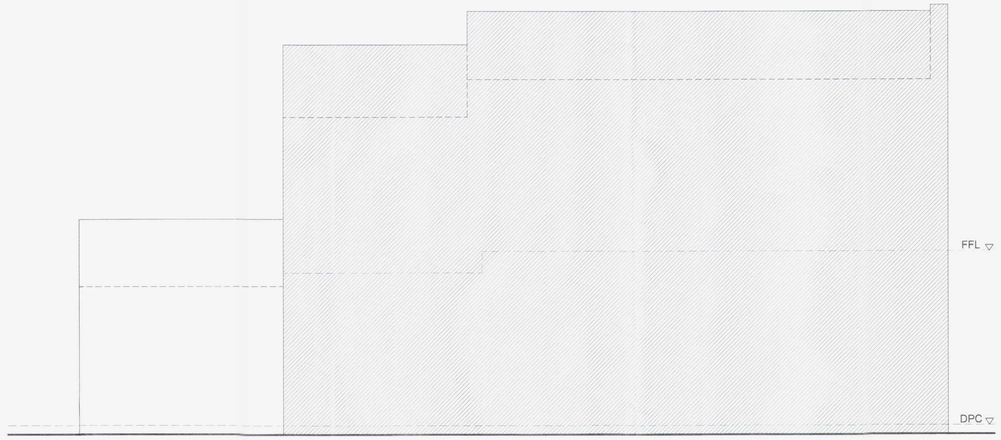

Side Elevation 1:~~100~~ 50
(see Agents letter dated 01.10.19)

Materials:

Roof:
All Glazed roof

Walls:
Render to match existing to rear wall,
White face brick to flank (side) wall

Fascia and soffit:
White flush PVCu Fascia (no soffit, as flush eaves)


Window:
Feature powder coated aluminium window to rear wall

Replace existing rear double doors with Feature powder coated aluminium version

ITEMS SHOWN DASHED TO BE REMOVED



Rear Elevation 1:~~100~~ 50
(see Agents letter dated 01.10.19)

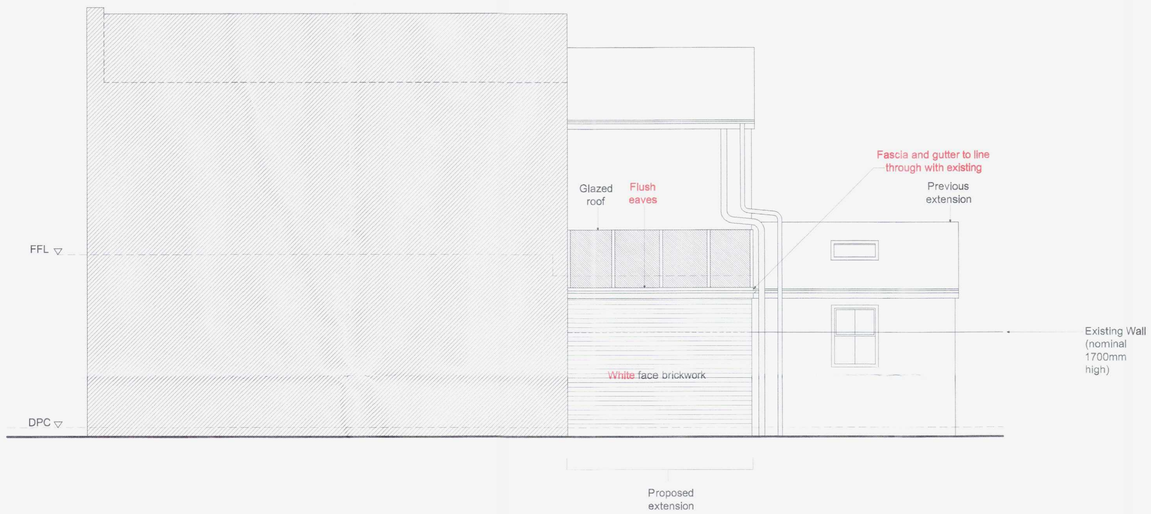

Side Elevation 1:~~100~~ 50
(see Agents letter dated 01.10.19)

1m 2m 3m 4m 5m
1:100 Scale Bar
1m 2m 3m 4m 5m
1:50 Scale Bar

FOR PLANNING

Rev.	Date	Description	By
A	Sep.'19	Revised for Planning	-

Client
Ms Cairncross

Project
Alterations To:
22 John Street,
Shoreham-by-sea

Drawing Title
Elevations
as Proposed

Copyright (c) 2019 all:
Sussex Architectural Services
Wicket View
Cuckfield Lane
Warninglid
West Sussex
Tel:(01444) 461355
Email: info@sussexarchitecturalservices.co.uk

Scale ~~1:100~~ 1:50 @ A1	Drawing Number 19-101-04 A
Date July 2019	
Drawn -	