Materials as per consent granted

Red line - proposed amendment

Dashed line = as per consent

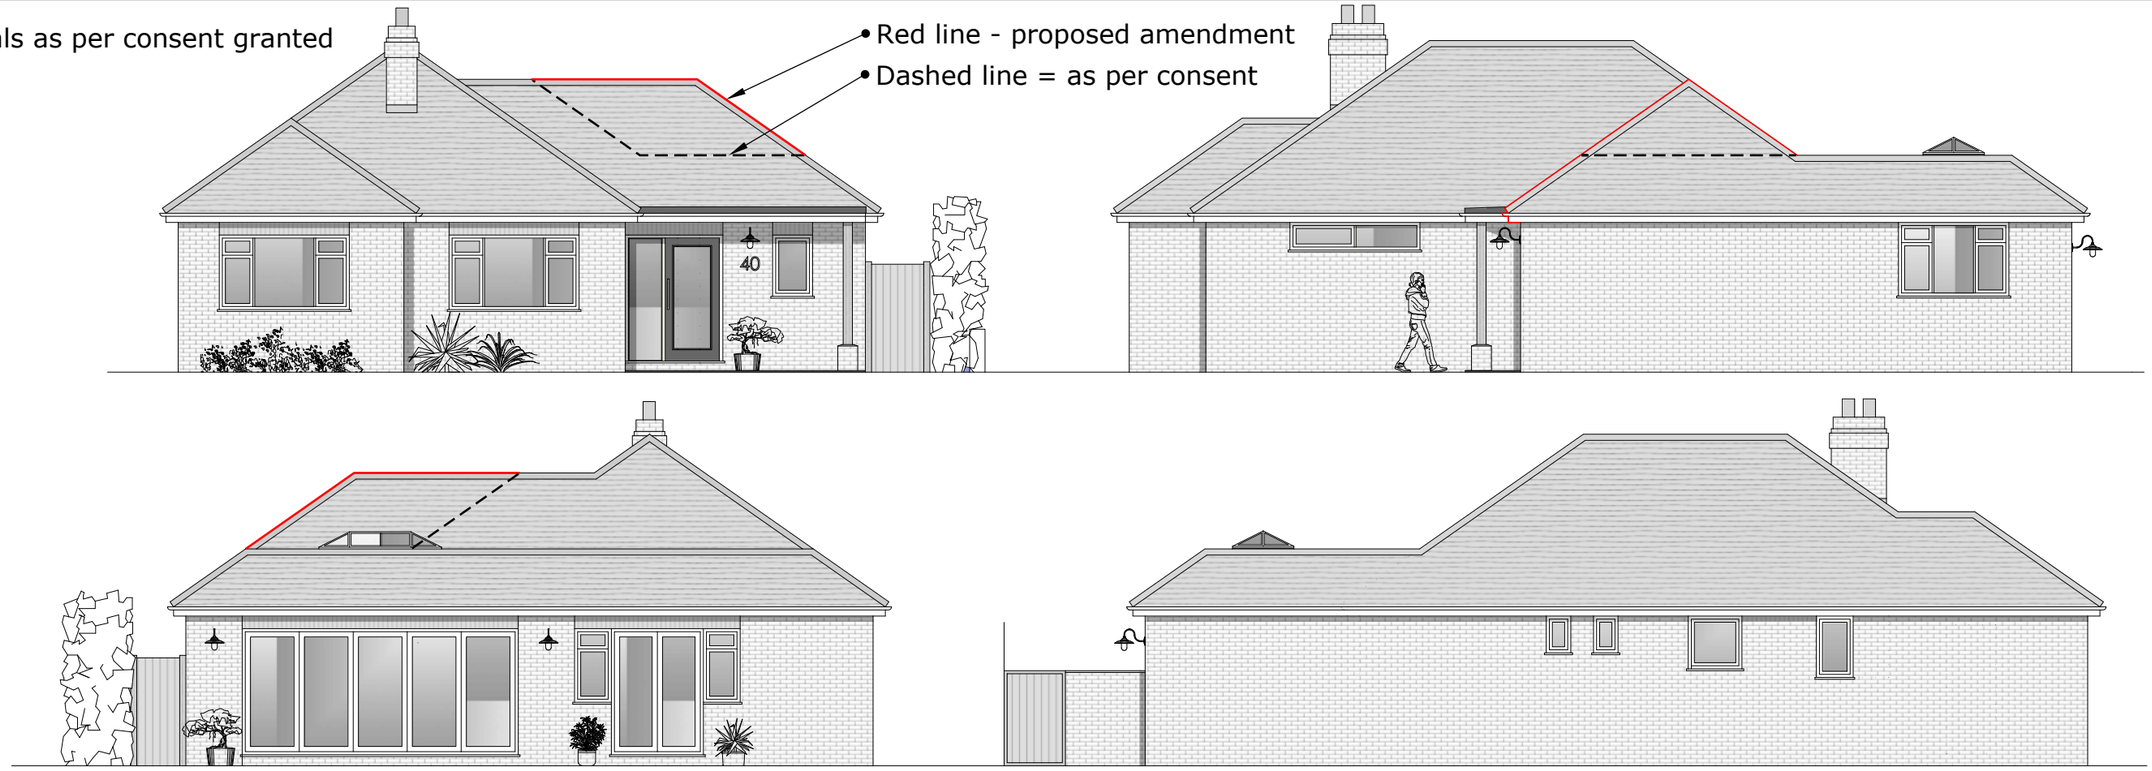

Proposed roof change - shown in red (exstg hip pulled forward)

deadspace DESIGNS

Proposed roof amendment (NMA)

40 Greenland Road,
Worthing,
West Sussex,
BN13 2RW

DRAWING: PLANS & ELEVATIONS TO SHOW REQUESTED AMENDMENT
SCALE: 1:100 @ A3
DATE: 08/ 04/ 2025
DRWG No: DS/ GREENLANDNMA/ 01

1:100 @ A1 paper size

0 1 2 3 4 5m

Dashed line = as per consent

