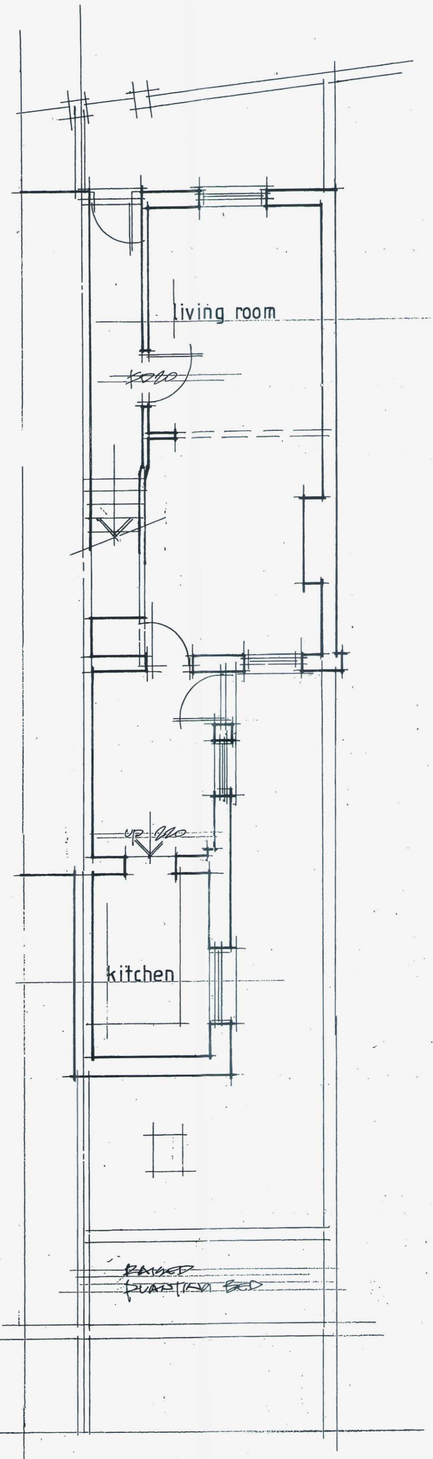

GROUND FLOOR PLAN

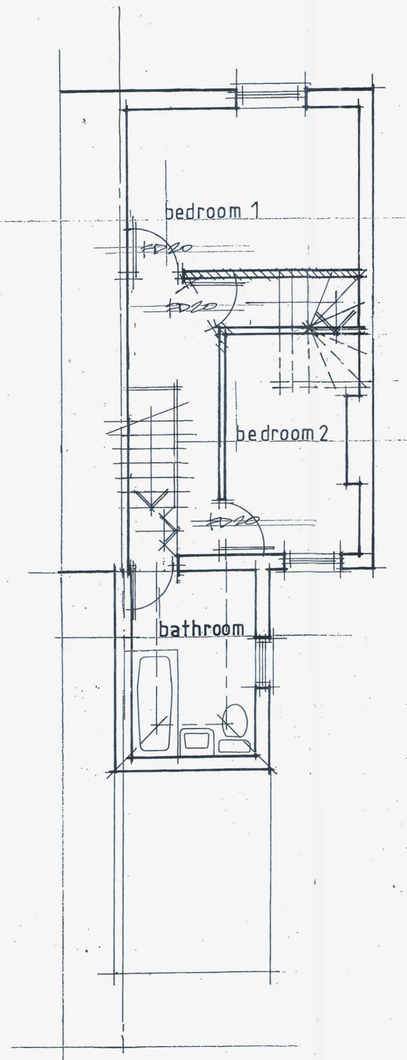

FIRST FLOOR PLAN

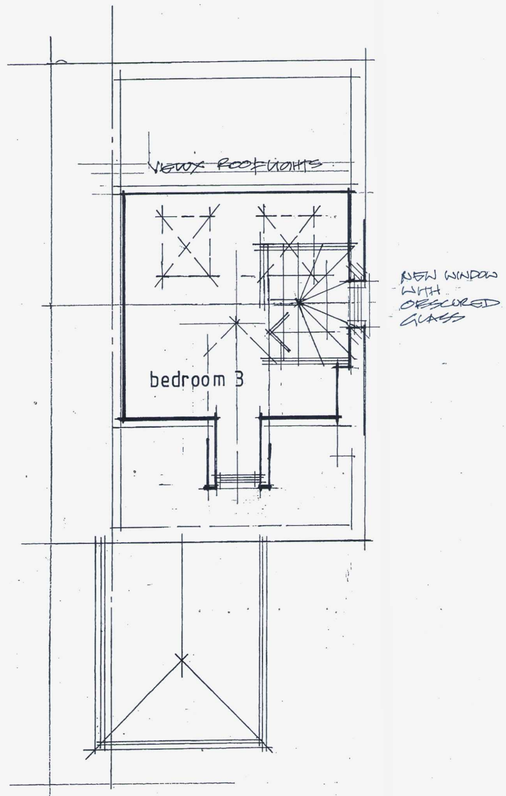

LOFT PLAN

0 1 2 3 4 5

SCALE 1:50

AMENDMENT

DESCRIPTION	DATE	REV
DORMER REDUCED IN SIZE	11/16	C
SKYLINE BAR REDRAWN	10/16	B
GABLE WALL WINDOW ADDED	09/16	A

DAVID F. EWINS R.IBA
ARCHITECT
31 BOSTON GARDENS
BRENTFORD
MIDDLESEX TW8 9LS
OFFICE 020 8560 7934
MOBILE 07814 727674

CLIENT

JOB
28 SHIP STREET
SHOREHAM by SEA

DRAWING TITLE
LOFT CONVERSION
floor plans

DATE ~~SEPTEMBER~~ 2016 DRAWN DE

SCALE 1:50 @ A1 ~~SIZE~~

ADUR & WORTHING PLANNING SERVICES
PLAN AWDM/1494/16
DATE ~~VALID~~ REC'D 23.11.16

JOB No	DRAWING No	REVISION
1331	05	C