SC

ADDITIONAL

ADUR & WORTHING
PLANNING SERVICES
PLAN AWDM/0163/15
DATE ~~VALID~~ REC'D 10/03/15

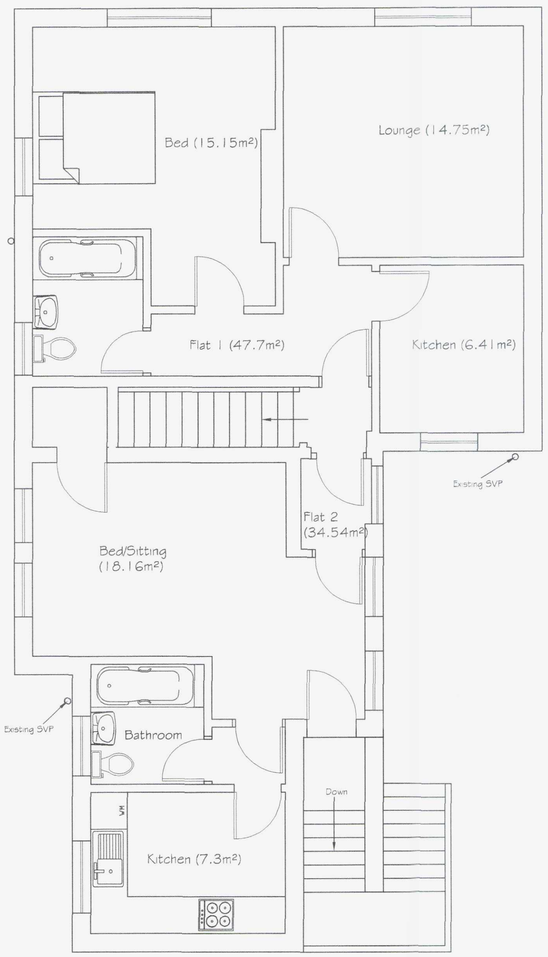

As Approved First Floor Plan

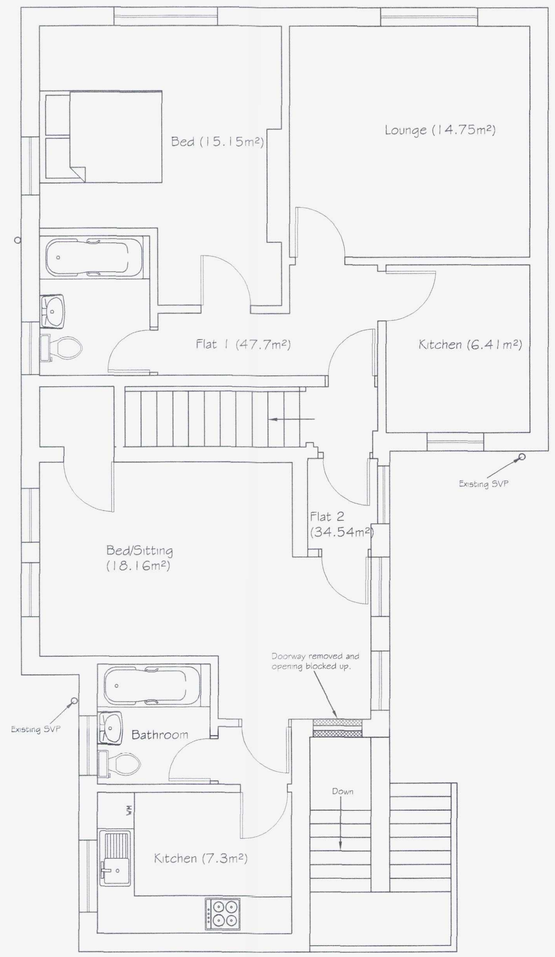

As Constructed First Floor Plan

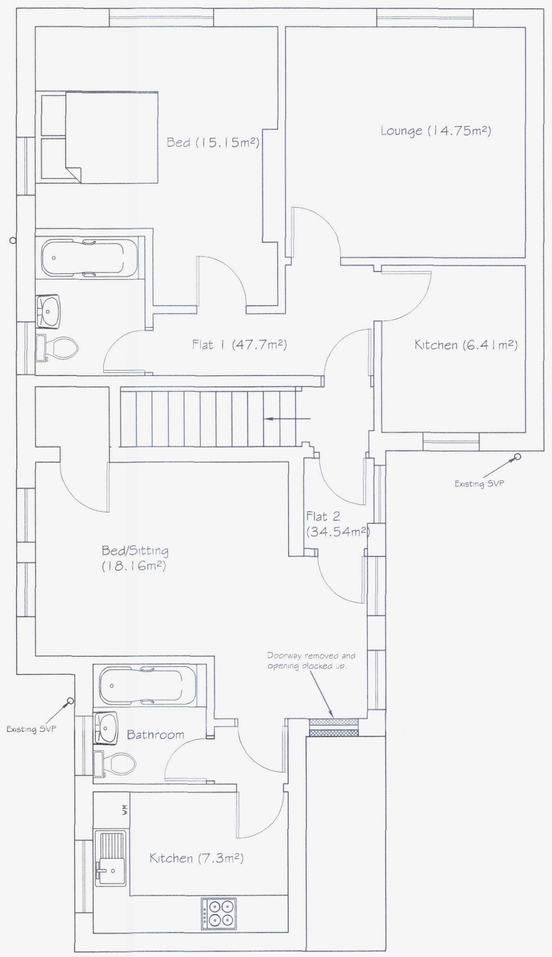

Proposed First Floor Plan



Tony Rogers
Building Consultants
Address: 40 Dawn Crescent, Upper Beeding
West Sussex, BN44 3WH
Telephone: 01903 815225 Fax: 01903 815225

Rev.	Date:	Revision Description:

Client: Mr & Mrs A Barnes

Address: 279-281 Albion Street
Southwick
West Sussex
BN42 4AT

Project: Proposed single storey rear/ side extension

Scale: 1:50
Paper Size A1

Date: January 2015

Drawing No: 12/773/06

Drawn By: AWR

Revision: