CITYZEN IS THE TRADING NAME FOR CITYZEN LIMITED; REGISTERED OFFICE: PRESTON PARK HOUSE, BRIGHTON, BN1 6SB; REGISTERED NUMBER: 10634993

A1 : 594 x 841

DEBENHAMS



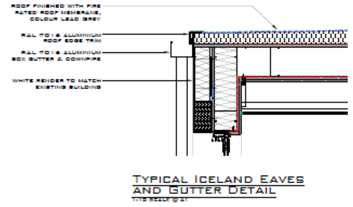

TYPICAL ICELAND EAVES AND GUTTER DETAIL
1:5 @ A1

EXCERPT FROM DRAWING 6820

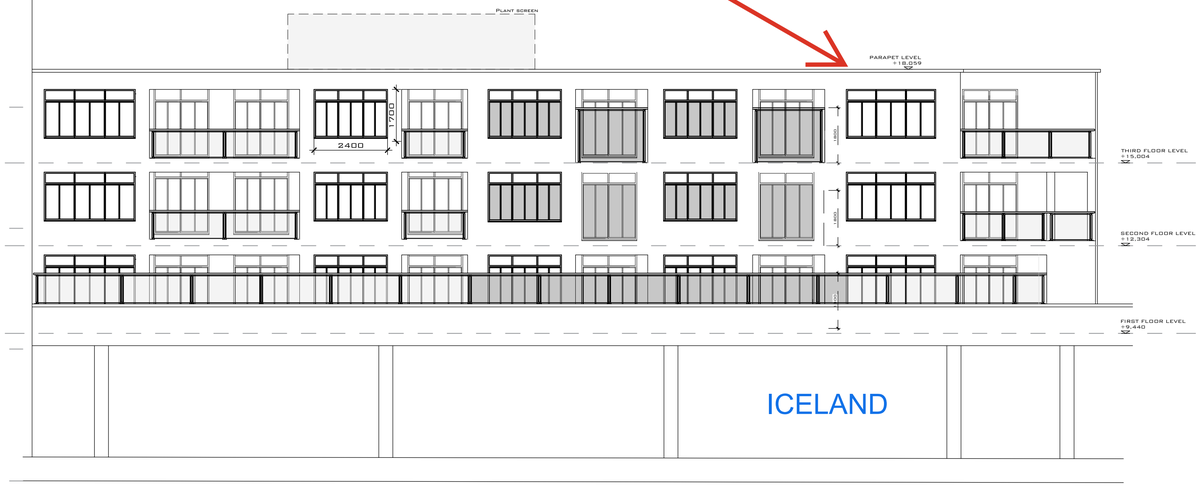

ICELAND

DEBENHAMS



PROPOSED WEST ELEVATIONS
1:100 SCALE @ A1

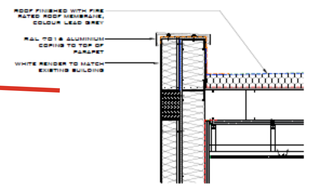

TYPICAL DEBENHAMS ROOF PARAPET DETAIL
1:5 @ A1

EXCERPT FROM DRAWING 6820

MARK UP SHOWING LOCATIONS OF ROOF DETAILS

NOTES:

- DRAWINGS SHOULD ONLY BE SCALED FOR PLANNING PURPOSES. DO NOT SCALE FROM THIS DRAWING FOR CONSTRUCTION PURPOSES.
- ALL DIMENSIONS ARE IN MM, UNLESS STATED OTHERWISE.
- ALL DIMENSIONS TO BE CHECKED ON SITE PRIOR TO CONSTRUCTION OR ORDERING.
- ANY ERRORS OR OMISSIONS TO BE NOTIFIED TO CITYZEN IMMEDIATELY.
- CONTRACTOR TO READ & CHECK ALL MANUFACTURES LITERATURE AND IMPLEMENT ITS REQUIREMENTS PRIOR TO INSTALLATION OF ANY MATERIALS AND COMPONENTS.
- CITYZEN IS NOT RESPONSIBLE FOR ANY BUILDING WORK THAT IS CARRIED OUT ON SITE.
- THIS DRAWING IS TO BE READ IN CONJUNCTION WITH ALL NECESSARY ARCHITECTURAL, STRUCTURAL AND SPECIALIST DRAWINGS, SPECIFICATIONS, SCOPES OF WORK & ROOM DATA SHEETS.
- ALL MATERIALS AND WORKMANSHIP SHALL CONFORM WITH THE RELEVANT BRITISH AND EUROPEAN STANDARD, SPECIFICATIONS AND CODES OF PRACTICE.
- ALL PROPERTY BOUNDARY LINES ARE ASSUMED.
- IF IN ANY DOUBT, ASK.

REV	DATE	REVISION	DRN	CHD	APP
P13	30.08.24	plant screen adjusted to match plan	RS	JS	JS
P12	08.08.24	Glazing subdivided to match plans	RS	JS	JS
P11	11.07.24	Revision clouds added for clarity	RS	JS	JS
P10	08.04.24	Plant area over 4th floor reduced	RS	JS	JS
P09	20.03.24	Updated for planning	RS	JS	JS
P08	07.02.24	Issued for planning	RS	JS	JS
P07	30.01.24	Updates to client comments for planning discussion	RS	JS	JS
P06	18.01.24	Layout updates and re-issue to planning	MQ	RS	RS
P05	31.07.23	Staircore 2 revised to serve all floors & lobby created	RS	RS	RS
P04	25.03.23	West elevation, opaque glazing added and minor amendments to SW corner.	JS	JS	JS
P03	03.03.23	Window treatment updated	JS	JS	JS
P02	18.10.22	Updated to fire engineer comments	RS	RS	RS
P01	06.10.22	Updated to client comments	MQ	RS	RS

CITYZEN ARCHITECTURE | ENVIRONMENT
MARITIME HOUSE
BASIN ROAD NORTH
HOVE
EAST SUSSEX
BN41 1WR
CONTACT@CITYZENDESIGN.CO.UK
WWW.CITYZENDESIGN.CO.UK
01273 915010
CIAT CHARTERED PRACTICE

COPYRIGHT CITYZEN LIMITED

CLIENT: CRAIG DEVELOPMENTS

PROJECT: DEBENHAMS

TITLE: PROPOSED WEST ELEVATION

DESIGNER: MATT QUINE

DATE: 04.10.22

REVISION: P13

PURPOSE OF DRAWING: INFORMATION

SUITABILITY: S1

RIBA STAGE: 3

DRAWING NUMBER: 2236-CTZ-XX-XX-DR-A-3052

0M 1M 2M 3M 4M 5M 10M
SCALE BAR @ 1:100

1:100 @ A1

File Path: Z:\01 Projects\Cityzen\2200\2236 Debenhams (via Maccon)\3 – Project Documentation\3.1 Drawings\02 – CAD\NMA Application\2236 MAIN – NMA App.dwg