GENERAL NOTES:
This drawing has been produced for our client and is submitted as part of a planning application / building regulations submission and is not intended for use by any other person or for any other purpose. Use of this drawing is subject to copyright.
The contractor is to check all site dims and levels before work starts and notify Architect of any discrepancies.This drawing must be read and checked against all structural and other specialist drawings and specifications etc. The contractor is to comply with all current British Standards and Building Regulations whether or not specifically stated on these drawings. Do not scale from this drawing.



South Elevation

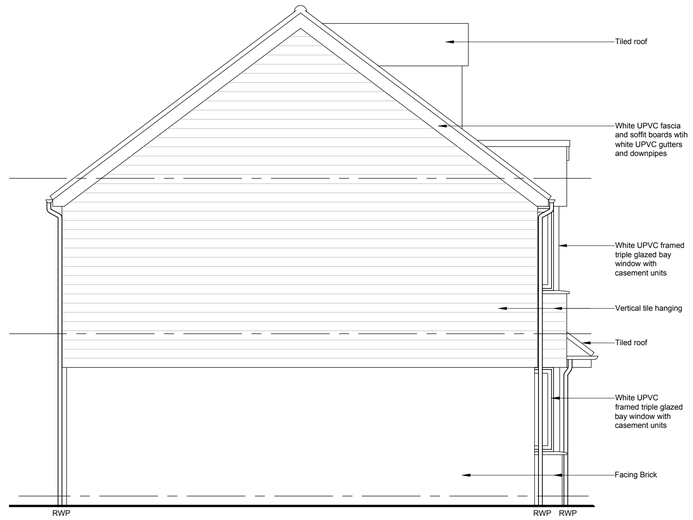

West Elevation

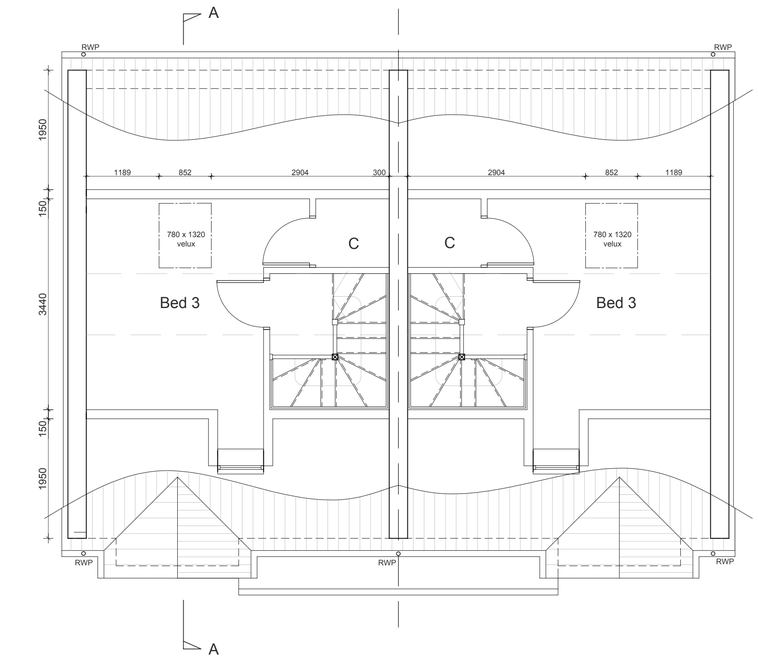

Second Floor Plan



North Elevation

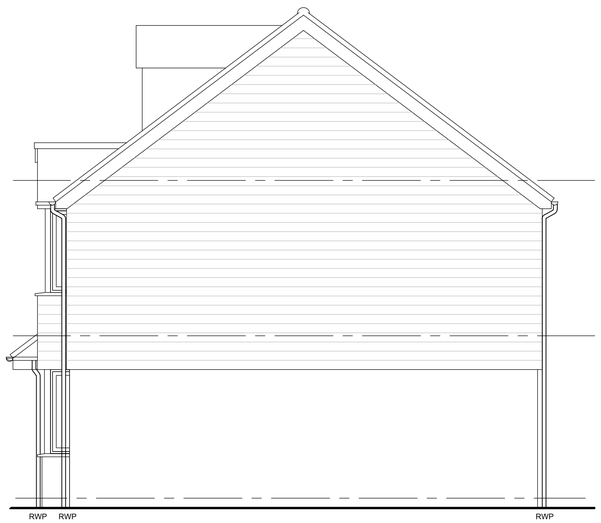

East Elevation

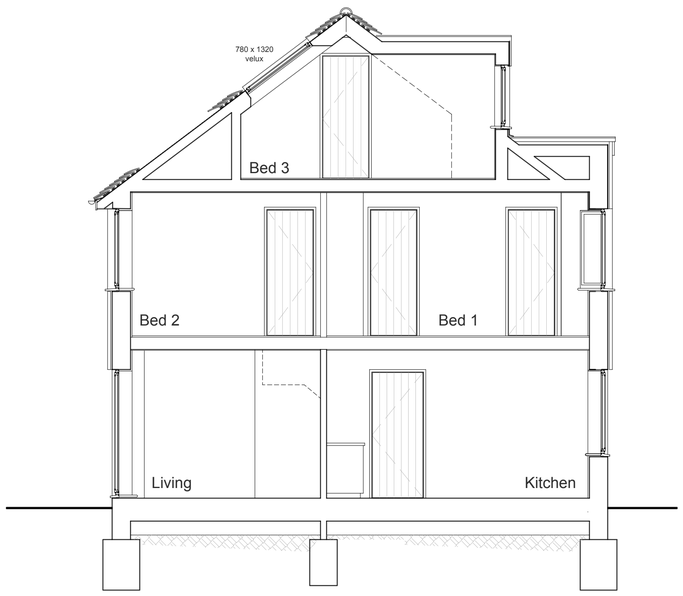

Section A-A

LIGHTBOX
ARCHITECTURE
L I M I T E D

121 Greenbank Avenue
Saltdean
East Sussex
BN2 8QF

07754 093827
email: info@lightboxarchitecture.com
web: www.lightboxarchitecture.com

© Lightbox Architecture Limited (UK) - 2019

1 : 50 0 0.5 1.0 1.5 2.0 2.5

Client
TL&Co Developments LTD

Address
126 Upper Shoreham Road
Shoreham-by-Sea,
West Sussex,
BN43 6TD.

Drawing
Plots 1 & 2
As built elevations, plans and sections
illustrating revised velux roof windows

~~PRELIMINARY~~ / PLANNING ~~/ BUILDING REGS~~

Rev.	Date	Description	By

Drawing Number
24/116/P12

Revision

Scale
1:50 @ A1

Date
04.09.2025

By
AB