

WEST



SOUTH



EAST

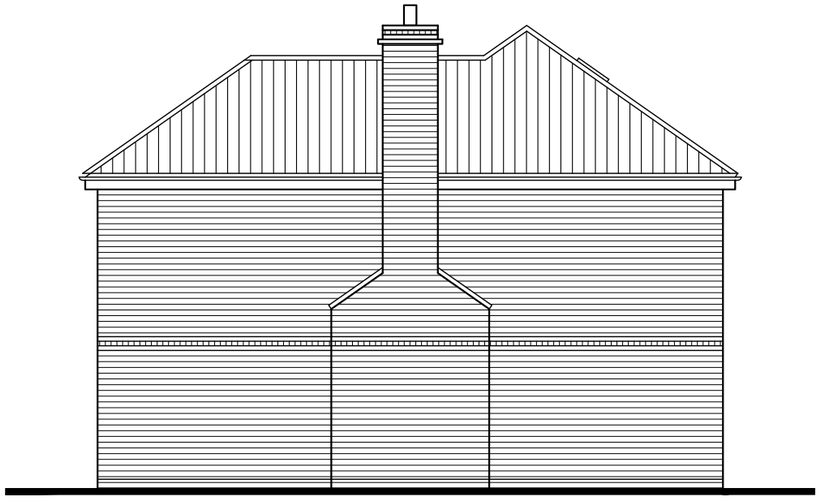

NORTH

Old Salts Nursery,
Old Salt Farm Rd,
Lancing,
West Sussex,
BN15 8JQ

'As Built' Elevations

Revisions

a) Roof Amendments/07.01.19/SAR
b)
c)
d)

CAAD
Critchley Architecture And Design Ltd.
Contact: 02392 474 919 | info@caad.online
The Old Brewery,15E South Street, Havant, PO9 1BU

N

Scale A1=1:50, A3=1:100
Drawn SAR
Date 14/12/18

A

0947–501

10m 20m 30m 40m